

1 LOCATION OF WATER WELL:	Fraction	Section Number	Township Number	Range Number
County: <u>McPherson</u>	<u>NW 1/4 NW 1/4 NE 1/4</u>	<u>28</u>	T <u>19</u> S	R <u>2</u> <u>EN</u>


Distance and direction from nearest town or city street address of well if located within city?

S Edge of Galva

2 WATER WELL OWNER:	Board of Agriculture, Division of Water Resources
RR#, St. Address, Box # :	Application Number:
City, State, ZIP Code :	

Galen Unruh
Rt 4, Box 35A
Galva, KS 67443

3 LOCATE WELL'S LOCATION WITH AN "X" IN SECTION BOX:	4 DEPTH OF COMPLETED WELL: <u>42</u> ft. ELEVATION:
--	---

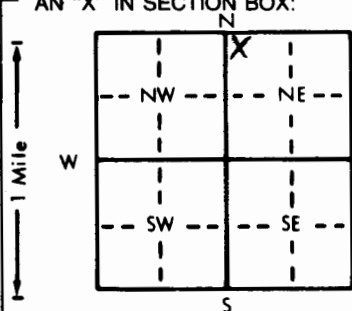

Depth(s) Groundwater Encountered 1. ft. 2. ft. 3. ft.

WELL'S STATIC WATER LEVEL 8 ft. below land surface measured on mo/day/yr 2-4-94

Pump test data: Well water was 2.7 ft. after 12 hours pumping 2.5 gpm

Est. Yield gpm: Well water was ft. after hours pumping gpm

Bore Hole Diameter 8 in. to 43 ft., and in. to ft.

WELL WATER TO BE USED AS:

5 Public water supply	8 Air conditioning	11 Injection well
<input checked="" type="radio"/> Domestic	3 Feedlot	6 Oil field water supply
2 Irrigation	4 Industrial	7 Lawn and garden only
		10 Monitoring well

Was a chemical/bacteriological sample submitted to Department? Yes No X If yes, mo/day/yr sample was submitted

Water Well Disinfected? Yes X No

5 TYPE OF BLANK CASING USED:	5 Wrought iron	8 Concrete tile	CASING JOINTS: Glued <u>X</u> Clamped
------------------------------	----------------	-----------------	---

1 Steel 3 RMP (SR) 6 Asbestos-Cement 9 Other (specify below) Welded

☒ PVC 4 ABS 7 Fiberglass Threaded

Blank casing diameter 5 in. to 32 ft., Dia in. to ft., Dia in. to ft.

Casing height above land surface 12 in., weight 2.37 lbs./ft. Wall thickness or gauge No. 16.0

TYPE OF SCREEN OR PERFORATION MATERIAL:

1 Steel	3 Stainless steel	5 Fiberglass	8 RMP (SR)	11 Other (specify)
2 Brass	4 Galvanized steel	6 Concrete tile	9 ABS	12 None used (open hole)

SCREEN OR PERFORATION OPENINGS ARE:

1 Continuous slot	3 Mill slot	5 Gauzed wrapped	<input checked="" type="radio"/> Saw cut	11 None (open hole)
2 Louvered shutter	4 Key punched	6 Wire wrapped	9 Drilled holes	
		7 Torch cut	10 Other (specify)	

SCREEN-PERFORATED INTERVALS: From 32 ft. to 42 ft., From ft. to ft.

From ft. to ft., From ft. to ft.

GRAVEL PACK INTERVALS: From 21 ft. to 43 ft., From ft. to ft.

From ft. to ft., From ft. to ft.

6 GROUT MATERIAL:	1 Neat cement	2 Cement grout	<input checked="" type="radio"/> Bentonite	4 Other
-------------------	---------------	----------------	--	-------------------

Grout Intervals: From 3 ft. to 21 ft., From ft. to ft., From ft. to ft.

What is the nearest source of possible contamination:

1 Septic tank	4 Lateral lines	7 Pit privy	10 Livestock pens	14 Abandoned water well
2 Sewer lines	5 Cess pool	8 Sewage lagoon	11 Fuel storage	15 Oil well/Gas well
<input checked="" type="radio"/> Watertight sewer lines	6 Seepage pit	9 Feedyard	12 Fertilizer storage	16 Other (specify below)
			13 Insecticide storage	

Direction from well? N How many feet? 50

FROM	TO	LITHOLOGIC LOG	FROM	TO	PLUGGING INTERVALS
------	----	----------------	------	----	--------------------

0	10	Gr Clay
10	12	F-C Sand
12	21	Br & Gr Clay
21	30	F Sand & Gr Clay layers
30	42	F-C Sand
42	43	Gr shale

7 CONTRACTOR'S OR LANDOWNER'S CERTIFICATION: This water well was <input checked="" type="radio"/> constructed, (2) reconstructed, or (3) plugged under my jurisdiction and was completed on (mo/day/year) <u>2-4-94</u> and this record is true to the best of my knowledge and belief. Kansas Water Well Contractor's License No. <u>447</u> This Water Well Record was completed on (mo/day/yr) <u>2-6-94</u> under the business name of <u>Miller Drilling</u> by (signature) <u>E Miller</u>
--