


1 LOCATION OF WATER WELL: Fraction NW 1/4 NW 1/4 NW 1/4 Section Number 15 Township Number T 19 S Range Number R 2 EAM

County: McPherson Distance and direction from nearest town or city street address of well if located within city?: 1 N Galva

2 WATER WELL OWNER: Wallace Lindberg Board of Agriculture, Division of Water Resources
 RR#, St. Address, Box #: 1576 21st Ave Application Number:
 City, State, ZIP Code: Galva, KS. 67443

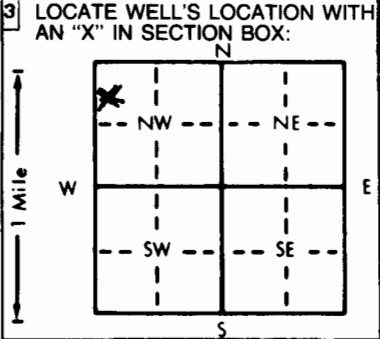

4 DEPTH OF COMPLETED WELL: 70 ft. ELEVATION:
 Depth(s) Groundwater Encountered 10 ft. 2. 42 ft. 3. 42 ft.
 WELL'S STATIC WATER LEVEL 10 ft. below land surface measured on mo/day/yr 6-19-98
 Pump test data: Well water was _____ ft. after _____ hours pumping _____ gpm
 Est. Yield 25 gpm: Well water was _____ ft. after _____ hours pumping _____ gpm
 Bore Hole Diameter 9 in. to _____ ft., and _____ in. to _____ ft.
 WELL WATER TO BE USED AS:
 5 Public water supply 8 Air conditioning 11 Injection well
 1 Domestic 3 Feedlot 6 Oil field water supply 9 Dewatering 12 Other (Specify below)
 2 Irrigation 4 Industrial 7 Lawn and garden only 10 Monitoring well
 Was a chemical/bacteriological sample submitted to Department? Yes _____ No X; If yes, mo/day/yr sample was submitted _____
 Water Well Disinfected? Yes X No _____

5 TYPE OF BLANK CASING USED:
 1 Steel 3 RMP (SR) 5 Wrought iron 8 Concrete tile CASING JOINTS: Glued X Clamped _____
 2 PVC 4 ABS 6 Asbestos-Cement 9 Other (specify below) Welded _____
 7 Fiberglass Threaded _____
 Blank casing diameter 5 in. to 5 1/2 in. Dia. _____ in. to _____ in. Dia. _____ in. to _____ in. Dia. _____
 Casing height above land surface 12 in. weight CLASS 160 lbs./ft. Wall thickness or gauge No. 214
 TYPE OF SCREEN OR PERFORATION MATERIAL:
 1 Steel 3 Stainless steel 5 Fiberglass 7 PVC 10 Asbestos-cement
 2 Brass 4 Galvanized steel 6 Concrete tile 8 RMP (SR) 11 Other (specify) _____
 9 ABS 12 None used (open hole)
 SCREEN OR PERFORATION OPENINGS ARE:
 1 Continuous slot 3 Mill slot 5 Gauzed wrapped 8 Saw cut 11 None (open hole)
 2 Louvered shutter 4 Key punched 6 Wire wrapped 9 Drilled holes
 7 Torch cut 10 Other (specify) _____
 SCREEN-PERFORATED INTERVALS: From 52 ft. to 70 ft., From _____ ft. to _____ ft.
 From _____ ft. to _____ ft., From _____ ft. to _____ ft.
 GRAVEL PACK INTERVALS: From 20 ft. to 70 ft., From _____ ft. to _____ ft.
 From _____ ft. to _____ ft., From _____ ft. to _____ ft.

6 GROUT MATERIAL: 1 Neat cement 2 Cement grout 3 Bentonite 4 Other _____
 Grout Intervals: From 0 ft. to 20 ft., From _____ ft. to _____ ft., From _____ ft. to _____ ft.
 What is the nearest source of possible contamination:
 1 Septic tank 4 Lateral lines 7 Pit privy 10 Livestock pens 14 Abandoned water well
 2 Sewer lines 5 Cess pool 8 Sewage lagoon 11 Fuel storage 15 Oil well/Gas well
 3 Watertight sewer lines 6 Seepage pit 9 Feedyard 12 Fertilizer storage 16 Other (specify below)
 13 Insecticide storage
 Direction from well? SE How many feet? 100+

FROM	TO	LITHOLOGIC LOG	FROM	TO	PLUGGING INTERVALS
<u>0</u>	<u>32</u>	<u>Sandy Clay.</u>			
<u>32</u>	<u>36</u>	<u>Clay</u>			
<u>36</u>	<u>42</u>	<u>Fine Sand</u>			
<u>42</u>	<u>67</u>	<u>Med "</u>			
<u>67</u>	<u>70</u>	<u>Clay + Shale</u>			

7 CONTRACTOR'S OR LANDOWNER'S CERTIFICATION: This water well was (1) constructed, (2) reconstructed, or (3) plugged under my jurisdiction and was completed on (mo/day/year) 6-19-91 and this record is true to the best of my knowledge and belief. Kansas Water Well Contractor's License No. 180 This Water Well Record was completed on (mo/day/yr) 7-1-98 under the business name of Backhus Drilling by (signature) Paul H. Backhus