


1 LOCATION OF WATER WELL:	Fraction	Section Number	Township Number	Range Number
County: Ness	NW 1/4 SW 1/4 NW 1/4	6	T 19 S	R 21 E

Distance and direction from nearest town or city street address of well if located within city?
1 mile south of Bazine, Ks.

2	WATER WELL OWNER:	Don Strecker	
	RR#, St. Address, Box # :	Box 206	Board of Agriculture, Division of Water Resources
	City, State, ZIP Code :	Bazine, Ks. 67516	Application Number: 6396 & 960040

3 LOCATE WELL'S LOCATION WITH AN "X" IN SECTION BOX: 4 DEPTH OF COMPLETED WELL... 53 ft. ELEVATION:

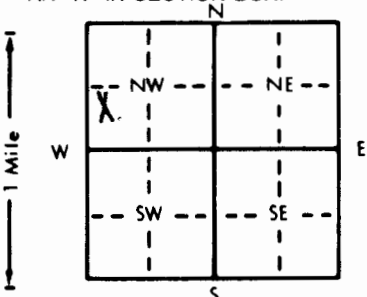

4 DEPTH OF COMPLETED WELL... 53 ... ft. ELEVATION: _____
 Depth(s) Groundwater Encountered 1. _____ ft. 2. _____ ft. 3. _____ ft.
 WELL'S STATIC WATER LEVEL ... 29. ... ft. below land surface measured on mo/day/yr 2-23-96
 Pump test data: Well water was _____ ft. after _____ hours pumping _____ gpm
 Est. Yield . 250 . gpm: Well water was 39 ... ft. after 2 ... hours pumping 250 ... gpm
 Bore Hole Diameter... 28. ... in. to ... 53 ... ft., and ... in. to ... ft.
 WELL WATER TO BE USED AS: 5 Public water supply 8 Air conditioning 11 Injection well
 1 Domestic 3 Feedlot 6 Oil field water supply 9 Dewatering 12 Other (Specify below)
 2 Irrigation 4 Industrial 7 Lawn and garden only 10 Monitoring well
 Was a chemical/bacteriological sample submitted to Department? Yes.....No...X.....; If yes, mo/day/yr sample was submitted
 Water Well Disinfected? Yes No X

5	TYPE OF BLANK CASING USED:		5 Wrought iron	8 Concrete tile	CASING JOINTS: Glued . X . . . Clamped
	1 Steel	3 RMP (SR)	6 Asbestos-Cement	9 Other (specify below)	Welded
	2 <u>PVC</u>	4 ABS	7 Fiberglass		Threaded

Blank casing diameter . . . 16 . . . in. to . . . 38 . . . ft., Dia . . . in. to . . . ft., Dia . . . in. to . . . ft.
Casing height above land surface . . . 12 . . . in., weight . . . SDR 32.5 . . . lbs./ft. Wall thickness or gauge No.

TYPE OF SCREEN OR PERFORATION MATERIAL:			<u>7 PVC</u>	10 Asbestos-cement
1 Steel	3 Stainless steel	5 Fiberglass	8 RMP (SR)	11 Other (specify)
2 Brass	4 Galvanized steel	6 Concrete tile	9 ABS	12 None used (open hole)

SCREEN OR PERFORATION OPENINGS ARE:

1 <u>Continuous</u> slot	3 Mill slot	5 Gauzed wrapped	8 Saw cut	11 None (open hole)
2 Louvered shutter	4 Key punched	6 Wire wrapped	9 Drilled holes	
		7 Torch cut	10 Other (specify)	

SCREEN-PERFORATED INTERVALS:	From	38	ft. to	53	ft., From	ft. to	ft.
	From		ft. to		ft., From	ft. to	ft.
GRAVEL PACK INTERVALS:	From	53	ft. to	20	ft., From	ft. to	ft.
	From		ft. to		ft., From	ft. to	ft.

6. GROUT MATERIAL: 1 Neat cement 2 Cement grout 3 Bentonite 4 Other customer cemented
Grout Intervals: From . ft. to . ft., From . ft. to . ft., From . ft. to . ft.

What is the nearest source of possible contamination:			10 Livestock pens	14 <u>Abandoned water well</u>
1 Septic tank	4 Lateral lines	7 Pit privy	11 Fuel storage	15 Oil well/Gas well
2 Sewer lines	5 Cess pool	8 Sewage lagoon	12 Fertilizer storage	16 Other (specify below)
3 Watertight sewer lines	6 Seepage pit	9 Feedyard	13 Insecticide storage

Direction from well? west How many feet? 5'

[illegible]

7. CONTRACTOR'S OR LANDOWNER'S CERTIFICATION: This water well was (1) constructed, (2) reconstructed, or (3) plugged under my jurisdiction and was completed on (mo/day/year) 2-23-96 and this record is true to the best of my knowledge and belief. Kansas Water Well Contractor's License No. 134 This Water Well Record was completed on (mo/day/yr) 3-11-96 under the business name of Rosencrantz-Bemis by (signature) Fredia Hodson