


WATER WELL RECORD Form WWC-5 KSA 82a-1212

1 LOCATION OF WATER WELL: Fraction Section Number Township Number Range Number
 COUNTY: NESS SE 1/4 NW 1/4 NW 1/4 19 T 19 S R 21 W

Distance and direction from nearest town or city street address of well if located within city?
 FROM BEELER - 3 W. ON 96 - 4 S. LANE-NESS CO. LINE

2 WATER WELL OWNER: BRENNER, BEN
 RR#, St. Address, Box #: 10142 W. NESS CO. LINE RD Board of Agriculture, Division of Water Resources
 City, State, ZIP code : BEELER,, KS 67518- Application Number:

3 LOCATE WELL'S LOCATION WITH AN "X" IN SECTION BOX:

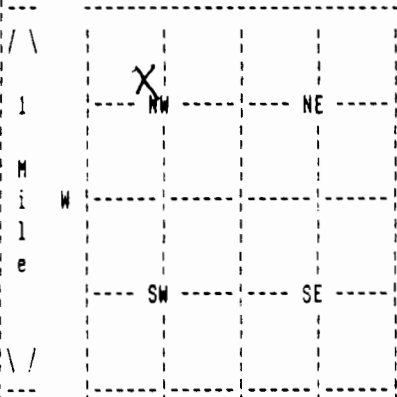

4 DEPTH OF COMPLETED WELL 60 ELEVATION: 0
 Depth(s) Groundwater Encountered 1. 0 ft. 2. 0 ft. 3. 0 ft.

WELL'S STATIC WATER LEVEL 33 ft. below land surface measured on mo/day/yr 12/20/10
 Pump testdata: Well water was 0 ft. after 0 hours pumping 0 gpm

Estimated Yield 35 gpm: Well water was 0 ft. after 0 hours pumping 0 gpm

Bore Hole Diameter 10 in. to 60 ft., and in. to 0 ft.

WELL WATER TO BE USED AS: DOMESTIC

Was a chemical/bacteriological sample submitted to department? No ;
 If yes, mo/day/yr sample was submitted Water well disinfected? Yes

5 TYPE OF BLANK CASING USED: CERTA LOC CASIN CASING JOINTS: CERTA-LOC
 Blank casing diameter 5 in. to 60 ft., Dia in. to 0 ft., Dia in. to 0 ft.
 Casing height above land surface 12 in., weight 200 lbs/ft. Wall thickness or gauge No. 21
 TYPE OF SCREEN OR PERFORATION MATERIAL: PVC
 SCREEN OR PERFORATION OPENINGS ARE: SAW CUT

SCREEN PERFORATED INTERVALS: From 20 ft. to 60 ft., From 0 ft. to 0 ft.
 From 0 ft. to 0 ft., From 0 ft. to 0 ft.
 GRAVEL PACK INTERVALS: From 20 ft. to 60 ft., From 0 ft. to 0 ft.
 From 0 ft. to 0 ft., From 0 ft. to 0 ft.

6 GROUT MATERIAL BENTONITE
 Grout Intervals: From 0 ft. to 20 ft., From 0 ft. to 0 ft., From 0 ft. to 0 ft.
 What is the nearest source of possible contamination: NONE
 Direction from well? How many feet? 0

FROM	TO	LITHOLOGIC LOG	FROM	TO	PLUGGING INTERVALS
0	20	01 TOPSOIL 05 CLAY 03 MEDIUM SAND			
20	40	37 FIN-COAR SAN 06 SMALL GRAVEL			
40	60	05 CLAY 37 FIN-COAR SAN 06 SMALL GRAVEL			
60	80	14 WHITE CLAY			
80	100	14 WHITE CLAY 07 BLUE SHALE			

7 CONTRACTOR'S OR LANDOWNER'S CERTIFICATION: This water well was Constructed under my jurisdiction and was completed on (mo/day/year) 12/20/10 and this record is true to the best of my knowledge and belief. Kansas Water Well Contractor's License No. 179 This Water Well Record was completed on (mo/day/yr) 12/31/10 under the business name of JOE'S WELL SERVICE, INC. by (signature) *Judith Crisk*