


1 LOCATION OF WATER WELL: County: Ness Fraction SE 1/4 SE 1/4 SE 1/4 Section Number 4 Township Number T 19 S Range Number R 22 E/W

Distance and direction from nearest town or city street address of well if located within city? Ness City 8 Miles East 9/10 Mile South 100' West 20' South

2 WATER WELL OWNER: Raymond Gross Board of Agriculture, Division of Water Resources RR#, St. Address, Box # : City, State, ZIP Code : Bazine, Kansas 67516 Application Number:

3 LOCATE WELL'S LOCATION WITH AN "X" IN SECTION BOX:

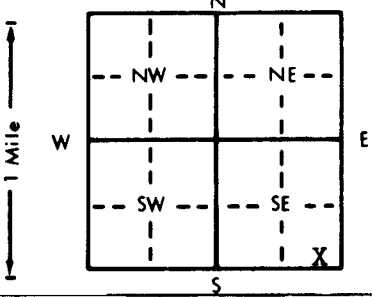

4 DEPTH OF COMPLETED WELL: 54 ft. ELEVATION: WELL'S STATIC WATER LEVEL: 32 ft. below land surface measured on mo/day/yr 8-3-85. Pump test data: Well water was ft. after hours pumping gpm. Est. Yield gpm: Well water was ft. after hours pumping gpm. Bore Hole Diameter: 10-5/8 in. to 54 ft., and in. to ft. WELL WATER TO BE USED AS: 1 Domestic, 2 Irrigation, 3 Feedlot, 4 Industrial, 5 Public water supply, 6 Oil field water supply, 7 Lawn and garden only, 8 Air conditioning, 9 Dewatering, 10 Observation well, 11 Injection well, 12 Other (Specify below). Was a chemical/bacteriological sample submitted to Department? Yes No X; If yes, mo/day/yr sample was submitted. Water Well Disinfected? Yes X No

5 TYPE OF BLANK CASING USED: 1 Steel, 2 PVC, 3 RMP (SR), 4 ABS, 5 Wrought iron, 6 Asbestos-Cement, 7 Fiberglass, 8 Concrete tile, 9 Other (specify below), CASING JOINTS: Glued X, Clamped, Welded, Threaded. Blank casing diameter: 5 in. to 34 ft., Dia in. to ft., Dia in. to ft. Casing height above land surface: 12 in., weight 26 lbs./ft. Wall thickness or gauge No. 258. TYPE OF SCREEN OR PERFORATION MATERIAL: 1 Steel, 2 Brass, 3 Stainless steel, 4 Galvanized steel, 5 Fiberglass, 6 Concrete tile, 7 PVC, 8 RMP (SR), 9 ABS, 10 Asbestos-cement, 11 Other (specify), 12 None used (open hole). SCREEN OR PERFORATION OPENINGS ARE: 1 Continuous slot, 2 Louvered shutter, 3 Mill slot, 4 Key punched, 5 Gauzed wrapped, 6 Wire wrapped, 7 Torch cut, 8 Saw cut, 9 Drilled holes, 10 Other (specify), 11 None (open hole). SCREEN-PERFORATED INTERVALS: From 34 ft. to 54 ft., From ft. to ft. GRAVEL PACK INTERVALS: From 20 ft. to 54 ft., From ft. to ft.

6 GROUT MATERIAL: 1 Neat cement, 2 Cement grout, 3 Bentonite, 4 Other. Grout Intervals: From 0 ft. to 10 ft., From ft. to ft., From ft. to ft. What is the nearest source of possible contamination: 1 Septic tank, 2 Sewer lines, 3 Watertight sewer lines, 4 Lateral lines, 5 Cess pool, 6 Seepage pit, 7 Pit privy, 8 Sewage lagoon, 9 Feedyard, 10 Livestock pens, 11 Fuel storage, 12 Fertilizer storage, 13 Insecticide storage, 14 Abandoned water well, 15 Oil well/Gas well, 16 Other (specify below), 17 NA. Direction from well? How many feet?

FROM	TO	LITHOLOGIC LOG	FROM	TO	LITHOLOGIC LOG
		Test Log Attached			

7 CONTRACTOR'S OR LANDOWNER'S CERTIFICATION: This water well was (1) constructed, (2) reconstructed, or (3) plugged under my jurisdiction and was completed on (mo/day/year) 8-3-85 and this record is true to the best of my knowledge and belief. Kansas Water Well Contractor's License No. 208 This Water Well Record was completed on (mo/day/yr) 8-20-85 under the business name of Minter-Wilson Drilling Company, Inc. by (signature) Nora Keller

INSTRUCTIONS: Use typewriter or ball point pen, PLEASE PRESS FIRMLY and PRINT clearly. Please fill in blanks, underline or circle the correct answers. Send top three copies to Kansas Department of Health and Environment, Division of Environment, Environmental Geology Section, Topeka, KS 66620. Send one to WATER WELL OWNER and retain one for your records.

OFFICE USE ONLY T R EW SEC. 1/4 1/4 1/4 1/4

*The
Professionals*

MINTER-WILSON DRILLING CO.
INCORPORATED

and Domestic
Water Systems
Complete Installation
and Repairing

Phone 276-8269 • P.O. Box A • GARDEN CITY, KANSAS 67846

Ray Gross
Ness County
8-3-85

Location: SE 4-19-22
From Ness City 8 Miles East 9/10 Mile
south 100' West 20' South of house.
House well & a test hole

Test #1

0	3	Top Soil
3	30	Brown Clay
30	50	Black Clay
50	54	Fine to medium sand and gravel (loose)
54	55	Shale