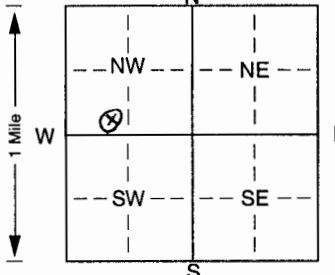


1 LOCATION OF WATER WELL: Fraction SE 1/4 NW 1/4 NW 1/4 Section Number 21 Township Number T 15 S R 25 Range Number EW  
 County: Miami  
 Distance and direction from nearest town or city street address of well if located within city?

2 WATER WELL OWNER: Pete & Heidi Selenke  
 RR#, St. Address, Box # : 22045 Nall Board of Agriculture, Division of Water Resources  
 City, State, ZIP Code : Bucyrus, KS 66013 Application Number:

3 LOCATE WELL'S LOCATION WITH AN "X" IN SECTION BOX:  4 DEPTH OF COMPLETED WELL... 150 ft. ELEVATION: .....  
 Depth(s) Groundwater Encountered 1. 80 ft. 2. 125 ft. 3. .... ft.  
 WELL'S STATIC WATER LEVEL... 45 ft. below land surface measured on mo/day/yr 4/08/05  
 Pump test data: Well water was ..... ft. after ..... hours pumping ..... gpm  
 Est. Yield ± 3 gpm: Well water was ..... ft. after ..... hours pumping ..... gpm  
 Bore Hole Diameter... 10 in. to 150 ft., and ..... in. to ..... ft.  
 WELL WATER TO BE USED AS: 5 Public water supply 8 Air conditioning 11 Injection well  
1 Domestic 3 Feedlot 6 Oil field water supply 9 Dewatering 12 Other (Specify below)  
 2 Irrigation 4 Industrial 7 Domestic (lawn & garden) 10 Monitoring well .....  
 Was a chemical/bacteriological sample submitted to Department? Yes. .... No. X ; If yes, mo/day/yr sample was submitted  
 Water Well Disinfected? Yes X No

5 TYPE OF BLANK CASING USED: 5 Wrought iron 8 Concrete tile CASING JOINTS: Glued. ✓ Clamped. ....  
 1 Steel 3 RMP (SR) 6 Asbestos-Cement 9 Other (specify below) Welded .....  
2 PVC 4 ABS 7 Fiberglass ..... Threaded. ....  
 Blank casing diameter ..... 5 in. to 80 ft., Dia ..... 5 in. to 100 ft., Dia ..... 5 in. to 140 ft.  
 Casing height above land surface. .... 18 in., weight ... SDR 21 ..... lbs./ft. Wall thickness or gauge No. 200 PSI .....  
 TYPE OF SCREEN OR PERFORATION MATERIAL: 7 PVC 10 Asbestos-cement  
 1 Steel 3 Stainless steel 5 Fiberglass 8 RMP (SR) 11 Other (specify) .....  
 2 Brass 4 Galvanized steel 6 Concrete tile 9 ABS 12 None used (open hole)  
 SCREEN OR PERFORATION OPENINGS ARE: 5 Gauzed wrapped 8 Saw cut 11 None (open hole)  
 1 Continuous slot 3 Mill slot 6 Wire wrapped 9 Drilled holes  
 2 Louvered shutter 4 Key punched 7 Torch cut 10 Other (specify) ..... ft.  
 SCREEN-PERFORATED INTERVALS: From... 80 ft. to ... 100 ft., From ... 130 ft. to ... 140 ft.  
 From ..... ft. to ..... ft., From ..... ft. to ..... ft.  
 GRAVEL PACK INTERVALS: From... 25 ft. to ... 150 ft., From ..... ft. to ..... ft.  
 From ..... ft. to ..... ft., From ..... ft. to ..... ft.

6 GROUT MATERIAL: 1 Neat cement 2 Cement grout 3 Bentonite 4 Other .....  
 Grout Intervals: From ..... 0 ft. to ... 25 ft., From ..... ft. to ..... ft., From ..... ft. to ..... ft.  
 What is the nearest source of possible contamination: 10 Livestock pens 14 Abandoned water well  
1 Septic tank 4 Lateral lines 7 Pit privy 11 Fuel storage 15 Oil well/Gas well  
 2 Sewer lines 5 Cess pool 8 Sewage lagoon 12 Fertilizer storage 16 Other (specify below)  
 3 Watertight sewer lines 6 Seepage pit 9 Feedyard 13 Insecticide storage .....  
 Direction from well? NE How many feet? + 200'

FROM	TO	LITHOLOGIC LOG	FROM	TO	PLUGGING INTERVALS
0	12	Clay			
12	48	Shale			
48	55	Limestone			
55	61	Shale			
61	82	Broken Limestone			
82	85	Black Shale			
85	89	Shale			
89	94	Limestone			
94	135	Shale			
135	141	Sandstone			
141	150	Shale			

7 CONTRACTOR'S OR LANDOWNER'S CERTIFICATION: This water well was (1) constructed, (2) reconstructed, or (3) plugged under my jurisdiction and was completed on (mo/day/year) ..... 4/08/05 ..... and this record is true to the best of my knowledge and belief. Kansas Water Well Contractor's Licence No. .... 595 ..... This Water Well Record was completed on (mo/day/yr) ... 4/26/05 ..... under the business name of Jesse Yoakum Well Drilling by (signature) Jesse Yoakum

INSTRUCTIONS: Use typewriter or ball point pen. PLEASE PRESS FIRMLY and PRINT clearly. Please fill in blanks, underline or circle the correct answers. Send top three copies to Kansas Department of Health and Environment, Bureau of Water, Topeka, Kansas 66620-0001. Telephone 785-296-5524. Send one to WATER WELL OWNER and retain one for your records. Fee of \$5.00 for each constructed well.