

WATER WELL PLUGGING RECORD Form WWC-5P

KSA 82a-1212

ID NO.

SELF NA

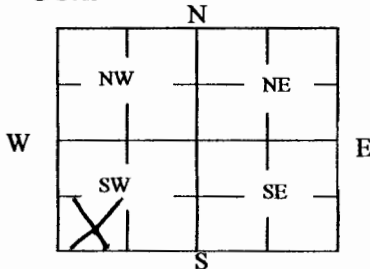
1 LOCATION OF WATER WELL: Fraction SW 1/4 1/4 1/4 1/4 Section Number 10 Township Number T 19 S 13 Range Number ☐ E ☒ W
 County: BARTON
 Street/Rural Address of Well Location; if unknown, distance & direction from nearest town or intersection: If at owner's address, check here ☐ 308 NE 10 AVE
GREAT BEND, KS 67530

Global Positioning Systems (GPS) information:
 Latitude: 38° 24' 23.04" N (in decimal degrees)
 Longitude: 98° 45' 23.62" W (in decimal degrees)
 Elevation: 1852 FT
 Horizontal Datum: ☐ WGS84, ☐ NAD83, ☐ NAD27
 Collection Method:

2 WATER WELL OWNER: GARY & RENEE DEMEL
 RR#, St. Address, Box #: 1618 BROADWAY
 City, State ZIP Code: GREAT BEND, KS 6753

☐ GPS unit (Make/Model):
☒ Digital Map/Photo, ☐ Topographic Map, ☐ Land Survey
 Est. Accuracy: ☐ < 3 m, ☒ 3-5 m, ☐ 5-15 m, ☐ > 15 m

3 MARK WELL'S LOCATION WITH AN "X" IN SECTION BOX:

4 DEPTH OF WELL 65 ft.WELL'S STATIC WATER LEVEL 35 ft

WELL WAS USED AS:

- ☒ Domestic
☐ Irrigation
☐ Feedlot
☐ Industrial

- ☐ Public Water Supply
☐ Oil Field Water Supply
☐ Domestic (Lawn & Garden)
☐ Air Conditioning

- ☐ Dewatering
☐ Monitoring
☐ Injection Well
☐ Other

Was a chemical/bacteriological sample submitted to Department? Yes ☐ No ☒

5 TYPE OF BLANK CASING USED:

- ☐ Steel ☐ RMP (SR) ☐ Wrought ☐ Fiberglass ☐ Other (Specify below)
☒ PVC ☐ ABS ☐ Asbestos-Cement ☐ Concrete Tile

Blank casing diameter 5 in. Was casing pulled? Yes ☐ No ☒ If yes, how much _____
 Casing height above or below land surface 36 in.

6 GROUT PLUG MATERIAL: ☒ Neat cement ☐ Cement grout ☐ Bentonite ☐ Other

Grout Plug Intervals: From _____ ft. to _____ ft., From _____ ft. to _____ ft., From _____ ft. to _____ ft.

What is the nearest source of possible contamination:

- ☐ Septic tank ☐ Seepage pit ☐ Fuel storage ☐ Other (specify below)
☒ Sewer lines ☐ Pit privy ☐ Fertilizer storage
☐ Watertight sewer lines ☐ Sewage lagoon ☐ Insecticide storage
☐ Lateral lines ☐ Feedyard ☐ Abandoned water well
☐ Cess pool ☐ Livestock pens ☐ Oil well/Gas well

Direction from well? N/E
 How many feet? 30 FT.

FROM	TO	PLUGGING MATERIALS	FROM	TO	PLUGGING MATERIALS
<u>65</u>	<u>30</u>	<u>GRAVEL</u>			
<u>30</u>	<u>5</u>	<u>NATIVE DIRT</u>			
<u>5</u>	<u>3</u>	<u>PORTLAND CONCRETE</u>			
<u>3</u>	<u>0</u>	<u>NATIVE DIRT</u>			

7 CONTRACTOR'S OR LANDOWNER'S CERTIFICATION: This water well was plugged under my jurisdiction and was completed on (mo/day/year) 7-18-2018 and this record is true to the best of my knowledge and belief. Kansas Water Well Contractor's License No. OWNER. This Water Well Record was completed on (mo/day/year) NA under the business name of NA by (signature) Gary R Demel

Send one white copy to Kansas Department of Health & Environment, Geology Section, 1000 SW Jackson Street, Ste. 420, Topeka, KS 66612-1367. Send one copy to WATER WELL OWNER and retain one for your records.
 Visit us at <http://www.kdheks.gov/waterwell/index.html> Telephone 785-296-5524.

KSA82a-1212

Revised 1/20/2015