


WATER WELL RECORD Form WWC-5 KSA 82a-1212

1 LOCATION OF WATER WELL: Fraction Section Number Township Number Range Number
 COUNTY: NESS NE 1/4 NE 1/4 NW 1/4 35 T 19 S R 24 W

Distance and direction from nearest town or city street address of well if located within city?
 FROM NESS CITY ON HIGHWAY 96 - 7 MILES WEST

2 WATER WELL OWNER: D.E. BONDURANT GRAIN CO.
 RR#, St. Address, Box #: 223 S. IOWA AVE. Board of Agriculture, Division of Water Resources
 City, State, ZIP code: NESS CITY, KS 67560- Application Number:

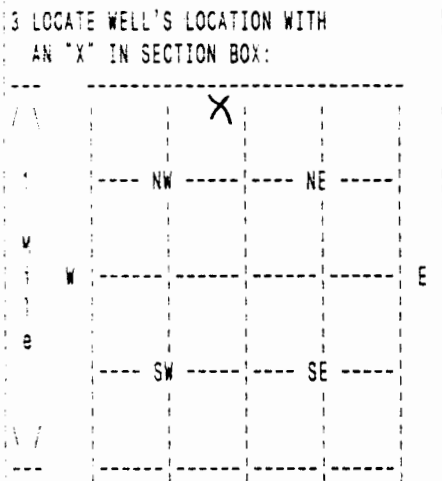

4 DEPTH OF COMPLETED WELL 60 ELEVATION: 0
 Depth(s) Groundwater Encountered 1. 0 ft. 2. 0 ft. 3. 0 ft.
 WELL'S STATIC WATER LEVEL 18 ft. below land surface measured on mo/day/yr 11/19/08
 Pump test data: Well water was 0 ft. after 0 hours pumping 0 gpm
 Estimated Yield 2 gpm: well water was 0 ft. after 0 hours pumping 0 gpm
 Bore Hole Diameter 10 in. to 60 ft., and in. to 0 ft.
 WELL WATER TO BE USED AS: DOMESTIC
 Was a chemical/bacteriological sample submitted to department? No ;
 If yes, mo/day/yr sample was submitted Water well disinfected? Yes

5 TYPE OF BLANK CASING USED: CERTA LOC CASIN CASING JOINTS: CERTA-LOC
 Blank casing diameter 5 in. to 60 ft., Dia in. to 0 ft., Dia in. to 0 ft.
 Casing height above land surface 12 in., weight 200 lbs/ft. Wall thickness or gauge No. 21
 TYPE OF SCREEN OR PERFORATION MATERIAL: PVC
 SCREEN OR PERFORATION OPENINGS ARE: SAW CUT

SCREEN PERFORATED INTERVALS: From 20 ft. to 40 ft., From 0 ft. to 0 ft.
 From 0 ft. to 0 ft., From 0 ft. to 0 ft.
 GRAVEL PACK INTERVALS: From 18 ft. to 60 ft., From 0 ft. to 0 ft.
 From 0 ft. to 0 ft., From 0 ft. to 0 ft.

6 GROUT MATERIAL BENTONITE
 Grout Intervals: From 0 ft. to 18 ft., From 0 ft. to 0 ft., From 0 ft. to 0 ft.
 What is the nearest source of possible contamination: NONE
 Direction from well? How many feet? 0

FROM	TO	LITHOLOGIC LOG	FROM	TO	PLUGGING INTERVALS
0	20	01 TOPSOIL 32 TAN CLAY 16 GRAY CLAY			
20	40	16 GRAY CLAY 36 BLUE CLAY			
40	60	36 BLUE CLAY			

7 CONTRACTOR'S OR LANDOWNER'S CERTIFICATION: This water well was Constructed under my jurisdiction and was completed on (mo/day/year) 11/19/08 and this record is true to the best of my knowledge and belief. Kansas Water Well Contractor's License No. 179 This Water Well Record was completed on (mo/day/yr) 12/11/08 under the business name of JOE'S WELL SERVICE, INC. by (signature) *Judith Criet*