USE TYPEWRITER OR BALL POINT PEN-PRESS FIRMLY, PRINT CLEARLY.

T R EW sec 1/4 1/4 1/4 No.

WATER WELL RECORD
KSA 82a-1201-1215

Kansas State Dept. Of Health
(Water Well Contractors)
Forbes-Bldg. 740
Topeka, Kansas 66620

1 Location of well:	County	Township name	Fraction	Section number	Town number	Range number
	Ness	Framl;om	SE NE¼ NE¼	#22	19	24

Distance and direction from nearest town or city: 2 miles west 4½ south of Ness City

Street address of well location if in city:

3 Owner of well: Rod Barrows

Address: Ness City, Ks 67560

Locate with "X" in section below:

Sketch map:

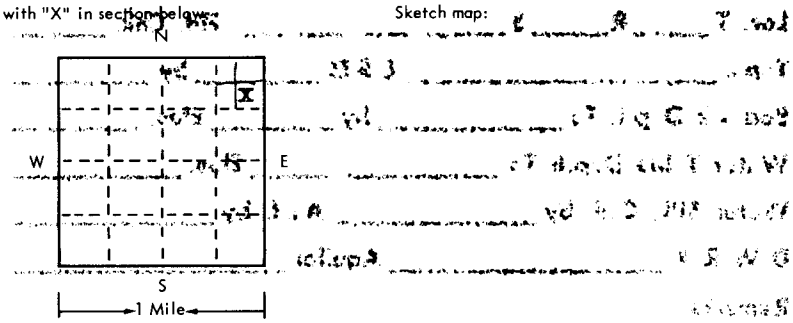

4 Well depth: 80 ft. Date of completion 5-18-75

Well diameter 7 3/4 in.

5 ☐ Cable tool ☒ Rotary ☐ Driven ☐ Dug ☐ Hollow rod ☐ Jetted ☐ Bored ☐ Reverse rotary

6 Use: ☒ Domestic ☐ Public supply ☐ Industry ☐ Irrigation ☐ Air conditioning ☐ Commercial ☐ Test well ☐

7 Casing: Material Plastic Height: above/below

Threaded ☐ Welded ☒ Surface ___ in.

Diam. 5" Weight 250 lbs./ft.

0 in. to 80 ft. depth Drive shoe? ☐ Yes ☒ No

___ in. to ___ ft. depth

2

Type and color of material	From	To
Clay	0	20
Gravel, broken rock	20	40
Loose clay balls	40	70
Shale	70	80
BROCK 70		
40		
30' sal Hull		
in Alluvium		
(use a second sheet if needed)		

8 Screen: Dealer

Manufacturer W A Brown Enterprises

Type Plastic Dia. 5"

Slot/gauze ___ Length 1/16 x 1½

Set between 60 ft. and 80 ft.

Fittings:

Gravel pack ☒ Yes ☐ No Size range of material 1/16

9 Static water level: 40 ft. below land surface Date 5-18-75

10 Pumping level below land surfaces:

___ ft. after ___ hrs. pumping ___ g.p.m.

___ ft. after ___ hrs. pumping ___ g.p.m.

Estimated maximum yield 10 g.p.m.

11 Water sample submitted: ☐ Yes ☒ No Date ___

12 Well head completion: ☐ Pitless adapter ☒ Inches above grade

13 Well grouted? ☒ Yes ☐ No

☐ Neat cement ☐ Bentonite ☒ clay

Depth: From 0 ft. to 10 ft.

14 Nearest source of possible contamination: 1 mi ft. Direction SE Type Oil well

Well disinfected upon completion? ☐ Yes ☒ No

15 Pump: ☒ Not installed

Manufacturer's name ___

Model number ___ HP ___ Volts ___

Length of drop pipe ___ ft. capacity ___ g.m.p.

Type: ☐ Submersible ☐ Turbine ☐ Jet ☐ Reciprocating ☐ Certrifugal ☐ Other

16 Remarks: elevation

2270
70
2200

m High

Topography: ☐ Hill ☐ Slope ☐ Upland ☐ Valley Level

17 Water well contractor's certification:

This well was drilled under my jurisdiction and this report is true to the best of my knowledge and belief.

Business name Plains Drilling & Supply, Inc. License No. 136

Address Garden City, Ks.

Signed [signature] Date 6-18-75

Sec-Treas.

Forward the white, blue and pink copies to the Kansas State Dept. Of Health.

Form WWC-5

677-H