


1 LOCATION OF WATER WELL: Fraction  $\frac{1}{4}$  NW  $\frac{1}{4}$  NW  $\frac{1}{4}$  Section Number 9 Township Number T 19 S Range Number R 26 EW  
 County: Ness

Distance and direction from nearest town or city street address of well if located within city?  
 1/2 mi. South of Beeler, Ks.

2 WATER WELL OWNER: Malm Construction  
 RR#, St. Address, Box #: 331 Harrison  
 City, State, ZIP Code: Lindsborg, Ks. 67456  
 Board of Agriculture, Division of Water Resources  
 Application Number: 36-831

3 LOCATE WELL'S LOCATION WITH AN "X" IN SECTION BOX:  
 4 DEPTH OF COMPLETED WELL: 30 ft. ELEVATION:

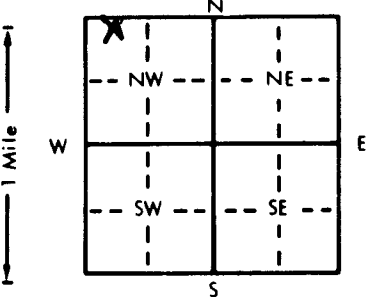

Depth(s) Groundwater Encountered 1. 8 ft. 2. ft. 3. ft.  
 WELL'S STATIC WATER LEVEL 8 ft. below land surface measured on mo/day/yr 11-9-84  
 Pump test data: Well water was ft. after hours pumping gpm  
 Est. Yield 45 gpm; Well water was ft. after hours pumping gpm  
 Bore Hole Diameter 8 in. to 30 ft., and in. to ft.  
 WELL WATER TO BE USED AS:  
 1 Domestic 3 Feedlot 6 Oil field water supply 9 Dewatering 12 Other (Specify below)  
 2 Irrigation 4 Industrial 7 Lawn and garden only 10 Observation well  
 Was a chemical/bacteriological sample submitted to Department? Yes No ; If yes, mo/day/yr sample was submitted  
 Water Well Disinfected? Yes  No

5 TYPE OF CASING USED:  
 1 Steel 3 RMP (SR) 5 Wrought iron 8 Concrete tile CASING JOINTS: Glued  Clamped  
 2 PVC 4 ABS 6 Asbestos-Cement 9 Other (specify below) Welded  
 7 Fiberglass Threaded  
 Blank casing diameter 5 in. to 20 ft., Dia. in. to ft., Dia. in. to ft.  
 Casing height above land surface 12 in., weight 2.91 lbs./ft. Wall thickness or gauge No. 265

TYPE OF SCREEN OR PERFORATION MATERIAL:  
 1 Steel 3 Stainless steel 5 Fiberglass 8 RMP (SR) 10 Asbestos-cement  
 2 Brass 4 Galvanized steel 6 Concrete tile 9 ABS 11 Other (specify)  
 12 None used (open hole)

SCREEN OR PERFORATION OPENINGS ARE:  
 1 Continuous slot 3 Mill slot 5 Gauzed wrapped 8 Saw cut 11 None (open hole)  
 2 Louvered shutter 4 Key punched 6 Wire wrapped 9 Drilled holes  
 7 Torch cut 10 Other (specify)

SCREEN-PERFORATED INTERVALS: From 20 ft. to 30 ft., From ft. to ft.  
 GRAVEL PACK INTERVALS: From 15 ft. to 30 ft., From ft. to ft.

6 GROUT MATERIAL: 1 Neat cement 2 Cement grout 3 Bentonite 4 Other  
 Grout Intervals: From 5 ft. to 15 ft., From ft. to ft., From ft. to ft.

What is the nearest source of possible contamination:  
 1 Septic tank 4 Lateral lines 7 Pit privy 10 Livestock pens 14 Abandoned water well  
 2 Sewer lines 5 Cess pool 8 Sewage lagoon 11 Fuel storage 15 Oil well/Gas well  
 3 Watertight sewer lines 6 Seepage pit 9 Feedyard 12 Fertilizer storage 16 Other (specify below)  
 13 Insecticide storage  
 Direction from well? None within 1/4 mi. How many feet?

| FROM | TO | LITHOLOGIC LOG          | FROM | TO | LITHOLOGIC LOG |
|------|----|-------------------------|------|----|----------------|
| 0    | 4  | Top Soil                |      |    |                |
| 4    | 9  | Brown Clay + Limestone  |      |    |                |
| 9    | 21 | Medium Sand + Limestone |      |    |                |
| 21   | 30 | Gray Shale              |      |    |                |

7 CONTRACTOR'S OR LANDOWNER'S CERTIFICATION: This water well was (1) constructed, (2) reconstructed, or (3) plugged under my jurisdiction and was completed on (mo/day/year) 6-9-84 and this record is true to the best of my knowledge and belief. Kansas Water Well Contractor's License No. 135 This Water Well Record was completed on (mo/day/yr) 6-28-84 under the business name of Peterson Irrigation by (signature) Mike Peterson  
 INSTRUCTIONS: Use typewriter or ball point pen, PLEASE PRESS FIRMLY and PRINT clearly. Please fill in blanks, underline or circle the correct answers. Send top three copies to Kansas Department of Health and Environment, Division of Environment, Environmental Geology Section, Topeka, KS 66620. Send one to WATER WELL OWNER and retain one for your records.

OFFICE USE ONLY

T

R

EW

SEC.

1/4

1/4

1/4