

(DRL)


WATER WELL PLUGGING RECORD Form WWC-5P KSA 82a-1212 ID NO.

Blank box for ID number

1 LOCATION OF WATER WELL: County: Lane Fraction SW 1/4 NW 1/4 W 1/4 NW 1/4 Section Number 10 Township Number T 19 S Range Number 29 [ ] E [x] W

Street/Rural Address of Well Location: if unknown, distance & direction from nearest town or intersection: If at owner's address, check here [ ] Dighton 3 miles west to Ike Rd, south 4 miles to Rd. 110, 680' south 50' east to well. Global Positioning Systems (GPS) information: Latitude: (in decimal degrees) Longitude: (in decimal degrees) Elevation: Horizontal Datum: [ ] WGS84, [ ] NAD83, [ ] NAD27 Collection Method: [ ] GPS unit (Make/Model: Digital Map/Photo, [ ] Topographic Map, [ ] Land Survey Est. Accuracy: [ ] < 3 m, [ ] 3-5 m, [ ] 5-15 m, [ ] > 15 m

2 WATER WELL OWNER: McWhirter - Campbell LLC RR#, St. Address, Box #: P O Box 524 City, State ZIP Code: Dighton, KS 67839

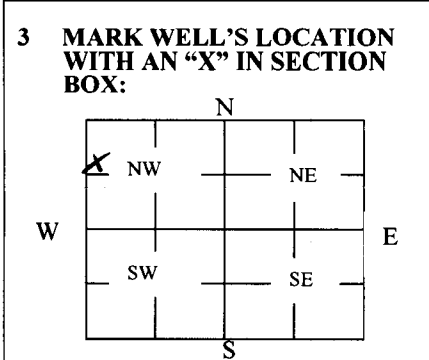

4 DEPTH OF WELL 72' ft. WELL'S STATIC WATER LEVEL None ft. WELL WAS USED AS: [ ] Domestic [ ] Irrigation [ ] Feedlot [ ] Industrial [ ] Public Water Supply [ ] Oil Field Water Supply [ ] Domestic (Lawn & Garden) [ ] Air Conditioning [ ] Dewatering [ ] Monitoring [x] Injection Well [ ] Other Stock Was a chemical/bacteriological sample submitted to Department? Yes [ ] No [x]

5 TYPE OF BLANK CASING USED: [x] Steel [ ] PVC [ ] RMP (SR) [ ] ABS [ ] Wrought [ ] Asbestos-Cement [ ] Fiberglass [ ] Concrete Tile [ ] Other (Specify below) Blank casing diameter 5 in. Was casing pulled? Yes [ ] No [x] If yes, how much Casing height above or below land surface 48 in.

6 GROUT PLUG MATERIAL: [ ] Neat cement [ ] Cement grout [x] Bentonite [ ] Other Grout Plug Intervals: From 4 ft. to 14 ft., From ft. to ft., From ft. to ft. What is the nearest source of possible contamination: [x] Septic tank [ ] Sewer lines [ ] Watertight sewer lines [ ] Lateral lines [ ] Cess pool [ ] Seepage pit [ ] Pit privy [ ] Sewage lagoon [ ] Feedyard [ ] Livestock pens [ ] Fuel storage [ ] Fertilizer storage [ ] Insecticide storage [ ] Abandoned water well [ ] Oil well/Gas well [ ] Other (specify below) Direction from well? West How many feet? 450'

Table with 6 columns: FROM, TO, PLUGGING MATERIALS, FROM, TO, PLUGGING MATERIALS. Rows: 0-4 Top Soil, 4-14 Bentonite Hole Plug, 14-72 Sand Gravel, Bentonite

7 CONTRACTOR'S OR LANDOWNER'S CERTIFICATION: This water well was plugged under my jurisdiction and was completed on (mo/day/year) 4-17-19 and this record is true to the best of my knowledge and belief. Kansas Water Well Contractor's License No. 532. This Water Well Record was completed on (mo/day/year) 5-3-19 under the business name of Midwest Well & Pump Inc. by (signature)

Send one white copy to Kansas Department of Health & Environment, Geology Section, 1000 SW Jackson Street, Ste. 420, Topeka, KS 66612-1367. Send one copy to WATER WELL OWNER and retain one for your records. Visit us at http://www.kdheks.gov/waterwell/index.html Telephone 785-296-5524.