


1 LOCATION OF WATER WELL: County: McPherson	Fraction CSL 1/4 SE 1/4 SW 1/4	Section Number 23	Township Number T 19 S	Range Number R 3 EW
---	--	-----------------------------	----------------------------------	-------------------------------

Distance and direction from nearest town or city street address of well if located within city?

2201 E. Kansas Avenue**AS-10**

2 WATER WELL OWNER: RR#, St. Address, Box # : City, State, ZIP Code :	Fina Oil & Chemical P O Box 2159 Dallas Texas 75221	Board of Agriculture, Division of Water Resources Application Number:
---	--	--

3 LOCATE WELL'S LOCATION WITH AN "X" IN SECTION BOX:	4 DEPTH OF COMPLETED WELL 49.5 ft. ELEVATION:
--	--

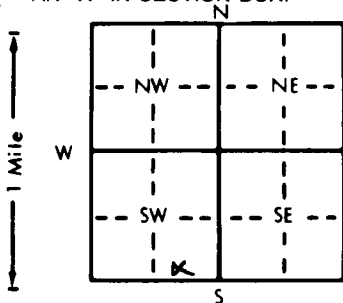

Depth(s) Groundwater Encountered 30 ft.	2. ft.	3. ft.	ft.
WELL'S STATIC WATER LEVEL 30 ft. below land surface measured on mo/day/yr			
Pump test data: Well water was	ft. after	hours pumping	gpm
Est. Yield	gpm	Well water was	ft. after
Bore Hole Diameter	in. to	ft. and	in. to
WELL WATER TO BE USED AS:			
1 Domestic	3 Feedlot	6 Oil field water supply	9 Dewatering
2 Irrigation	4 Industrial	7 Lawn and garden only	10 Monitoring well
Was a chemical/bacteriological sample submitted to Department? Yes No; If yes, mo/day/yr sample was submitted			
Water Well Disinfected? Yes No			

5 TYPE OF BLANK CASING USED:	5 Wrought iron	8 Concrete tile	CASING JOINTS: Glued Clamped
1 Steel	3 RMP (SR)	6 Asbestos-Cement	9 Other (specify below)
2 PVC	4 ABS	7 Fiberglass	Welded
Blank casing diameter	in. to	ft. Dia	in. to
Casing height above land surface	in. weight	lbs./ft. Wall thickness or gauge No.	
TYPE OF SCREEN OR PERFORATION MATERIAL:			
1 Steel	3 Stainless steel	5 Fiberglass	8 RMP (SR)
2 Brass	4 Galvanized steel	6 Concrete tile	9 ABS
SCREEN OR PERFORATION OPENINGS ARE:			
1 Continuous slot	3 Mill slot	5 Gauzed wrapped	8 Saw cut
2 Louvered shutter	4 Key punched	6 Wire wrapped	9 Drilled holes
SCREEN-PERFORATED INTERVALS:			
From	ft. to	ft. From	ft. to
GRAVEL PACK INTERVALS:	From	ft. to	ft. From
From	ft. to	ft. From	ft. to
From	ft. to	ft. From	ft. to

6 GROUT MATERIAL:	1 Neat cement	2 Cement grout	3 Bentonite	4 Other
Grout Intervals:	From	ft. to	ft. From	ft. to
What is the nearest source of possible contamination:				
1 Septic tank	4 Lateral lines	7 Pit privy	10 Livestock pens	14 Abandoned water well
2 Sewer lines	5 Cess pool	8 Sewage lagoon	11 Fuel storage	15 Oil well/Gas well
3 Watertight sewer lines	6 Seepage pit	9 Feedyard	12 Fertilizer storage	16 Other (specify below)
Direction from well? Gas Station				
How many feet? < 100'				

FROM	TO	LITHOLOGIC LOG	FROM	TO	PLUGGING INTERVALS
0	23	Silty sandy clay			
23	40	Sand			
40	53	Clay			
		Shale			

7 CONTRACTOR'S OR LANDOWNER'S CERTIFICATION: This water well was (1) constructed, (2) reconstructed, or (3) plugged under my jurisdiction and was completed on (mo/day/year) 10-5-95 and this record is true to the best of my knowledge and belief. Kansas Water Well Contractor's License No. 581 This Water Well Record was completed on (mo/day/yr) 10-9-95 under the business name of Layne, Inc by (signature) Steve Mitchell
--