


1 LOCATION OF WATER WELL: County: McPherson Fraction: NE 1/4 NW 1/4 SE 1/4 Section Number: 28 Township Number: T 19 S Range Number: R 3 EW

Distance and direction from nearest town or city street address of well if located within city?

806 East Kansas - McPherson, Kansas

2 WATER WELL OWNER: Bell Gas RR#, St. Address, Box #: P.O. Box 808 City, State, ZIP Code: McPherson, Kansas 67460 Board of Agriculture, Division of Water Resources Application Number:

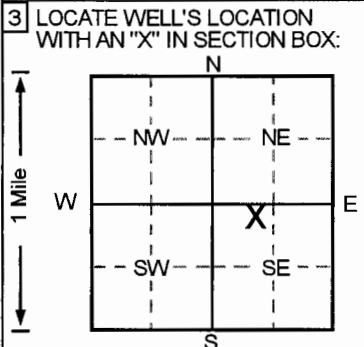

3 LOCATE WELL'S LOCATION WITH AN 'X' IN SECTION BOX: 4 DEPTH OF COMPLETED WELL: 63 ft. ELEVATION: 1482.72. Depth(s) Groundwater Encountered 1. 55 ft. 2. ft. 3. ft. WELL'S STATIC WATER LEVEL: 52.72 ft. below land surface measured on mo/day/yr 3/12/96. Pump test data: Well water was NA ft. after hours pumping gpm. Est. Yield NA gpm. Well water was ft. after hours pumping gpm. Bore Hole Diameter: 8 in. to 63 ft. and in. to ft. WELL WATER TO BE USED AS: 10 Monitoring well (checked). Was a chemical/bacteriological sample submitted to Department? Yes No. If yes, mo/day/yr sample was submitted. Water Well Disinfected? Yes No.

5 TYPE OF BLANK CASING USED: 2 PVC (checked). 5 Wrought iron, 8 Concrete tile, CASING JOINTS: Glued, Clamped. Welded, Threaded (checked). Blank casing diameter: 2 in. to 43 ft. Dia. in. to ft. Dia. in. to ft. Casing height above land surface: -7.08 in., weight lbs./ft. Wall thickness or gauge No. Sch. 40. TYPE OF SCREEN OR PERFORATION MATERIAL: 7 PVC (checked). 10 Asbestos-cement, 11 Other (specify). SCREEN OR PERFORATION OPENINGS ARE: 3 Mill slot (checked), 11 None (open hole). SCREEN-PERFORATED INTERVALS: From 43 ft. to 63 ft. GRAVEL PACK INTERVALS: From 40.5 ft. to 63 ft.

6 GROUT MATERIAL: 2 Cement grout (checked), 3 Bentonite (checked), 4 Other. Grout Intervals: From 0 ft. to 38.5 ft., From 38.5 ft. to 40.5 ft., From ft. to ft. What is the nearest source of possible contamination: 16 Other (specify below) UST Basin (checked).

Table with columns: FROM, TO, LITHOLOGIC LOG, FROM, TO, PLUGGING INTERVALS. Rows show soil profiles from 0 to 63 ft depth: Topsoil/Vegetation, Clay/Silt, Brown, Clay/Silt, Light Brown, Clay/Silt, Brown, Clay/Silt, Brown Gray, Clay/Silt, Gray, Clay/Silt, Light Brown. Additional info: MW3, Tag # 00162700, Flushmount; Project Name: Bell Gas #811; GeoCore # 199, KDHE # U5 059 897.

7 CONTRACTOR'S OR LANDOWNER'S CERTIFICATION: This water well was 1 constructed, 2 reconstructed, or 3 plugged under my jurisdiction and was completed on (mo/day/year) 3/8/96 and this record is true to the best of my knowledge and belief. Kansas Water Well Contractor's License No. 527 This Water Well Record was completed on (mo/day/yr) 3/25/96 under the business name of GeoCore Services, Inc. by (signature) Dale A. Bell