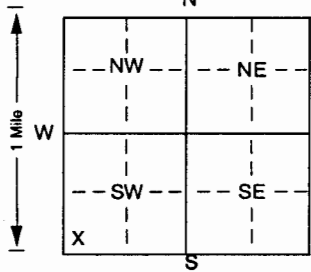


1 LOCATION OF WATER WELL:	Fraction	Section Number	Township Number	Range Number
County: McPherson	SW 1/4 SW 1/4 SW 1/4	35	T 19 S	R 3 E (W)

Distance and direction from nearest town or city street address of well if located within city?

Approximately 1 mile east of McPherson

2 WATER WELL OWNER:	Equus Beds GMD #2	Board of Agriculture, Division of Water Resources
RR#, St. Address, Box #	: 313 Spruce	Application Number:
City, State, ZIP Code	Halstead, KS 67056-1925	

3 LOCATE WELL'S LOCATION WITH AN "X" IN SECTION BOX:	4 DEPTH OF COMPLETED WELL 57 ft. ELEVATION: unknown
	Depth(s) Groundwater Encountered 1 ft. 2 ft. 3 ft.
	WELL'S STATIC WATER LEVEL 32.72 ft. below land surface measured on mo/day/yr 12-10-04
	Pump test data: Well water was not checked ft. after hours pumping gpm
	Est. Yield unknown gpm: Well water was ft. after hours pumping gpm
	Bore Hole Diameter 6 in. to 79 ft., and in. to ft.
WELL WATER TO BE USED AS:	
1 Domestic 3 Feedlot 6 Oil field water supply 8 Air conditioning 11 Injection well	
2 Irrigation 4 Industrial 7 Domestic (lawn & garden) 10 Monitoring well 12 Other (specify below)	
Was a chemical/bacteriological sample submitted to Department? Yes No <input checked="" type="checkbox"/> If yes, mo/day/yr sample was submitted	
Water Well Disinfected? Yes No <input checked="" type="checkbox"/>	

5 TYPE OF BLANK CASING USED:	5 Wrought iron	8 Concrete tile	CASING JOINTS: Glued Clamped
1 Steel	3 RMP (SR)	6 Asbestos-Cement	9 Other (specify below)
2 PVC	4 ABS	7 Fiberglass	10 Asbestos-cement
Blank casing diameter 2 (steel) in. to 7 ft., Dia 2 (PVC) in. to 44 ft., Dia			
Casing height above land surface 36 in., weight 3.65 (steel) .70 (PVC) lbs./ft. Wall thickness or gauge No .154 (steel) .154 (PVC)			
TYPE OF SCREEN OR PERFORATION MATERIAL:			
1 Steel 3 Stainless steel 5 Fiberglass 8 RMP (SR) 10 Asbestos-cement			
2 Brass 4 Galvanized steel 6 Concrete tile 9 ABS 11 Other (specify)			
12 None used (open hole)			
SCREEN OR PERFORATION OPENINGS ARE:			
1 Continuous slot 3 Mill slot 5 Gauzed wrapped 8 Saw cut 11 None (open hole)			
2 Louvered shutter 4 Key punched 6 Wire wrapped 9 Drilled holes 10 Other (specify) ft.			
SCREEN-PERFORATED INTERVALS: From 44 ft. to 54 ft., From ft. to ft.			
GRAVEL PACK INTERVALS: From 39 ft. to 57 ft., From ft. to ft.			

6 GROUT MATERIAL:	1 Neat cement	2 Cement grout	3 Bentonite	4 Other Bentonite Holeplug
Grout Intervals: From 4 ft. to 35 ft., From 0 ft. to 4 ft., From 35 ft. to 39 ft.				
What is the nearest source of possible contamination:				
1 Septic tank 4 Lateral lines 7 Pit privy 10 Livestock pens 14 Abandoned water well				
2 Sewer lines 5 Cess pool 8 Sewage lagoon 11 Fuel storage 15 Oil well/Gas well				
3 Watertight sewer lines 6 Seepage pit 9 Feedyard 12 Fertilizer storage 16 Other (specify below)				
13 Insecticide storage None known				
Direction from well? How many feet?				

FROM	TO	LITHOLOGIC LOG	FROM	TO	PLUGGING INTERVALS
0	4	Topsoil			
4	7	Clay, dark gray, hard			
7	18	Clay, brown, hard			
18	26	Sand and gravel, medium to fine with clay streak			
26	37	Clay, brown, hard, sandy			
37	48	Clay, gray, hard			
48	51	Clay, light gray, sandy			
51	54	Sand, medium to coarse			
54	70	Shale, green, hard			
70	79	Shale, black			

7 CONTRACTOR'S OR LANDOWNER'S CERTIFICATION: This water well was (1) constructed (2) reconstructed or (3) plugged under my jurisdiction and was completed on (mo/day/year) 12-10-04 and this record is true to the best of my knowledge and belief. Kansas Water Well Contractor's License No 185 This Water Well Record was completed on (mo/day/yr) 12-14-04 under the business name of Clarke Well & Equipment, Inc. by (signature) 