


AS-1D

1 LOCATION OF WATER WELL:	Fraction	Section Number	Township Number	Range Number
County: Mcperson	$\frac{1}{4}$ SE $\frac{1}{4}$ SW $\frac{1}{4}$	23	19S	3W

Distance and direction from nearest town or city street address of well if located within city?
2201 E. Kansas Avenue

2 WATER WELL OWNER: ATOFINA Petrochemicals, Inc.	Board of Agriculture, Division of Water Resources Application Number:
RR#, St. Address, Box # P.O. Box 674411	
City, State, ZIP Code : Houston, Texas 77267-4411	

3 MARK WELL'S LOCATION WITH AN "X" IN SECTION BOX:

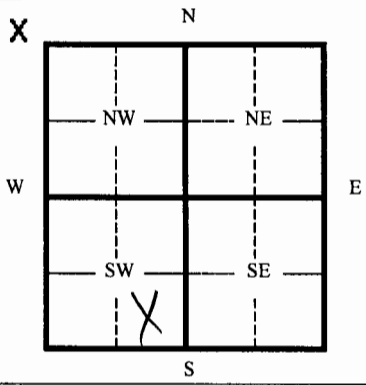

4 DEPTH OF WELL **50** ft.

WELL'S STATIC WATER LEVEL **Unknown** ft.

WELL WAS USED AS:

1 Domestic	5 Public Water Supply	9 Dewatering
2 Irrigation	6 Oil Field Water Supply	10 Monitoring Well
3 Feedlot	7 Lawn and Garden (domestic)	11 Injection Well
4 Industrial	8 Air Conditioning	12 Other

Was a chemical/bacteriological sample submitted to Department? Yes ___ No **X**

If yes, mo/day/yr sample was submitted _____

Water Well Disinfected: Yes ___ No **X**

5 TYPE OF BLANK CASING USED:

1 Steel	3 RMP (SR)	5 Wrought	7 Fiberglass	9 Other (specify below)
2 PVC	4 ABC	6 Asbestos-Cement	8 Concrete Tile	

Blank casing diameter **2** in. Was casing pulled? Yes **x** No ___ If yes, how much **3** ft.

Casing height above or below land surface **0** in.

6 GROUT PLUG MATERIAL: 1 Neat cement 2 Cement grout **3 Bentonite** 4 Other _____

Grout Plug Intervals From **0** ft. to **50** ft. From _____ ft. to _____ ft. From _____ ft. to _____ ft.

What is the nearest source of possible contamination:

1 Septic tank	6 Seepage pit	11 Fuel storage	16 Other (specify below)
2 Sewer lines	7 Pit privy	12 Fertilizer storage	
3 Watertight sewer lines	8 Sewage lagoon	13 Insecticide storage	
4 Lateral lines	9 Feedyard	14 Abandoned water well	
5 Cess Pool	10 Livestock pens	15 Oil well/ Gas well	

Direction from well? **Unknown** How many feet? **Unknown**

FROM	TO	CODE	PLUGGING MATERIALS
0	50		Bentonite Grout

7 CONTRACTOR'S OR LANDOWNER'S CERTIFICATION: This water well was plugged under my jurisdiction and was completed on (mo/day/yr) **3/21/05 to 3/25/05** and this record is true to the best of my knowledge and belief. Kansas Water Well Contractor's License No. **616** This Water Well Record was completed on (mo/day/yr) **5/24/05** under the business name of **Thiele Geotech, Inc.**

by (signature) *[Signature]*

INSTRUCTIONS: Please fill in blanks and circle the correct answers. Send three copies to Kansas Department of Health and Environment, Bureau of Water, Topeka, Kansas 66620-0001. Telephone: 785-296-3565. Send one to Water Well Owner and retain one for your records.