

UMW-8

2-40-3

WATER WELL PLUGGING RECORD

FORM WWC-5P

KSA 82a-1212


1 LOCATION OF WATER WELL:	Fraction	Section Number	Township Number	Range Number
County: Mcperson	NE 1/4 SW 1/4 NW 1/4	26	19S	3W

Distance and direction from nearest town or city street address of well if located within city?

30 ft. East 2201 E. Kansas Avenue

2 WATER WELL OWNER: ATOFINA Petrochemicals, Inc.	Board of Agriculture, Division of Water Resources Application Number:
RR#, St. Address, Box # P.O. Box 674411	
City, State, ZIP Code : Houston, Texas 77267-4411	

3 MARK WELL'S LOCATION WITH AN "X" IN SECTION BOX:

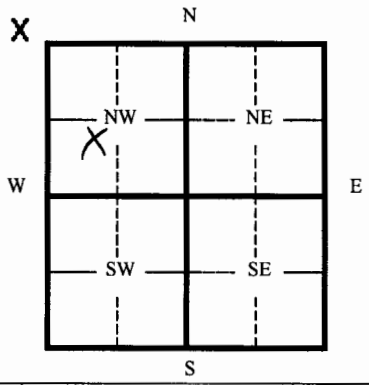

4 DEPTH OF WELL **40** ft.

WELL'S STATIC WATER LEVEL **Unknown** ft.

WELL WAS USED AS:

- | | | |
|--------------|------------------------------|---------------------------|
| 1 Domestic | 5 Public Water Supply | 9 Dewatering |
| 2 Irrigation | 6 Oil Field Water Supply | 10 <u>Monitoring Well</u> |
| 3 Feedlot | 7 Lawn and Garden (domestic) | 11 Injection Well |
| 4 Industrial | 8 Air Conditioning | 12 Other |

Was a chemical/bacteriological sample submitted to Department? Yes No **X**

If yes, mo/day/yr sample was submitted

Water Well Disinfected: Yes No **X**

5 TYPE OF BLANK CASING USED:
1 Steel 3 RMP (SR) 5 Wrought 7 Fiberglass 9 Other (specify below) 2 <u>PVC</u> 4 ABC 6 Asbestos-Cement 8 Concrete Tile
Blank casing diameter 2 in. Was casing pulled? Yes X No If yes, how much 3 ft.
Casing height above or below land surface 0 in.

6 GROUT PLUG MATERIAL:	1 Neat cement	2 Cement grout	<u>3 Bentonite</u>	4 Other
Grout Plug Intervals From 0 ft. to 40 ft. From ft. to ft. From ft. to ft.				

What is the nearest source of possible contamination:

- | | | | |
|--------------------------|-------------------|-------------------------|--------------------------|
| 1 Septic tank | 6 Seepage pit | 11 <u>Fuel storage</u> | 16 Other (specify below) |
| 2 Sewer lines | 7 Pit privy | 12 Fertilizer storage | |
| 3 Watertight sewer lines | 8 Sewage lagoon | 13 Insecticide storage | |
| 4 Lateral lines | 9 Feedyard | 14 Abandoned water well | |
| 5 Cess Pool | 10 Livestock pens | 15 Oil well/ Gas well | |

Direction from well? **Unknown** How many feet? **Unknown**

FROM	TO	CODE	PLUGGING MATERIALS
0	40		Bentonite Grout

7 CONTRACTOR'S OR LANDOWNER'S CERTIFICATION: This water well was plugged under my jurisdiction and was completed on (mo/day/yr) 3/21/05 to 3/25/05 and this record is true to the best of my knowledge and belief. Kansas Water Well Contractor's License No. 616 This Water Well Record was completed on (mo/day/yr) 5/24/05 under the business name of Thiele Geotech, Inc.
by (signature)

INSTRUCTIONS: Please fill in blanks and circle the correct answers. Send three copies to Kansas Department of Health and Environment, Bureau of Water, Topeka, Kansas 66620-0001. Telephone: 785-296-3565. Send one to Water Well Owner and retain one for your records.