

AS-12

2-50-2

WATER WELL PLUGGING RECORD

FORM WWC-5P

KSA 82a-1212

1 LOCATION OF WATER WELL:	Fraction	Section Number	Township Number	Range Number
County: Mcpherson	SW 1/4 SE 1/4 NW 1/4	26	19S	3W

Distance and direction from nearest town or city street address of well if located within city?

Northwest Corner of Champlin Avenue and Kansas Avenue2 WATER WELL OWNER: **ATOFINA Petrochemicals, Inc.**RR#, St. Address, Box # **P.O. Box 674411**

Board of Agriculture, Division of Water Resources

City, State, ZIP Code : **Houston, Texas 77267-4411**

Application Number:

3 MARK WELL'S LOCATION WITH AN "X" IN SECTION BOX:

4

DEPTH OF WELL **50** ft.WELL'S STATIC WATER LEVEL **Unknown** ft.

WELL WAS USED AS:

1 Domestic

5 Public Water Supply

9 Dewatering

2 Irrigation

6 Oil Field Water Supply

10 Monitoring Well

3 Feedlot

7 Lawn and Garden (domestic)

11 Injection Well

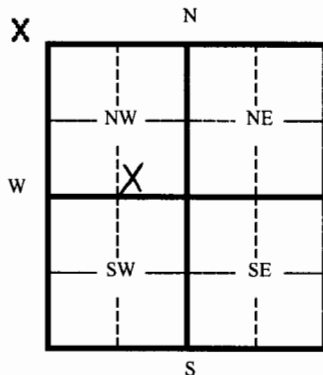
4 Industrial

8 Air Conditioning

12 Other

Was a chemical/bacteriological sample submitted to Department? Yes No **X**

If yes, mo/day/yr sample was submitted

Water Well Disinfected: Yes No **X**

5 TYPE OF BLANK CASING USED:

1 Steel

3 RMP (SR)

5 Wrought

7 Fiberglass

9 Other (specify below)

2 **PVC**

4 ABC

6 Asbestos-Cement

8 Concrete Tile

Blank casing diameter **2** in.Was casing pulled? Yes **X** No If yes, how much **3 ft.**Casing height above or below land surface **0** in.6 GROUT PLUG MATERIAL: 1 Neat cement 2 Cement grout **3 Bentonite** 4 OtherGrout Plug Intervals From **0** ft. to **50** ft. From ft. to ft. From ft. to ft.

What is the nearest source of possible contamination:

1 Septic tank

6 Seepage pit

11 **Fuel storage**

16 Other (specify below)

2 Sewer lines

7 Pit privy

12 Fertilizer storage

3 Watertight sewer lines

8 Sewage lagoon

13 Insecticide storage

4 Lateral lines

9 Feedyard

14 Abandoned water well

5 Cess Pool

10 Livestock pens

15 Oil well/ Gas well

Direction from well? **Unknown**How many feet? **Unknown**

FROM	TO	CODE	PLUGGING MATERIALS
0	50		Bentonite Grout

7 CONTRACTOR'S OR LANDOWNER'S CERTIFICATION: This water well was plugged under my jurisdiction and was completed on (mo/day/yr) **3/21/05 to 3/25/05** and this record is true to the best of my knowledge and belief. Kansas Water Well Contractor's License No. **616** This Water Well Record was completed on (mo/day/yr) **5/24/05** under the business name of **Thiele Geotech, Inc.**

by (signature) *D. J. A. C.*

INSTRUCTIONS: Please fill in blanks and circle the correct answers. Send three copies to Kansas Department of Health and Environment, Bureau of Water, Topeka, Kansas 66620-0001. Telephone: 785-296-3565. Send one to Water Well Owner and retain one for your records.