

mw-1

2-38-1

# WATER WELL PLUGGING RECORD

FORM WWC-5P


KSA 82a-1212

1 LOCATION OF WATER WELL:	Fraction	Section Number	Township Number	Range Number
County: <b>Mcpherson</b>	<b>NE ¼ SW ¼ NW ¼</b>	<b>26</b>	<b>19S</b>	<b>3W</b>

Distance and direction from nearest town or city street address of well if located within city?  
**40 ft. South of 2201 E. Kansas Avenue**

2 WATER WELL OWNER: <b>ATOFINA Petrochemicals, Inc.</b>	Board of Agriculture, Division of Water Resources Application Number:
RR#, St. Address, Box # <b>P.O. Box 674411</b>	
City, State, ZIP Code : <b>Houston, Texas 77267-4411</b>	

3 MARK WELL'S LOCATON WITH AN "X" IN SECTION BOX:

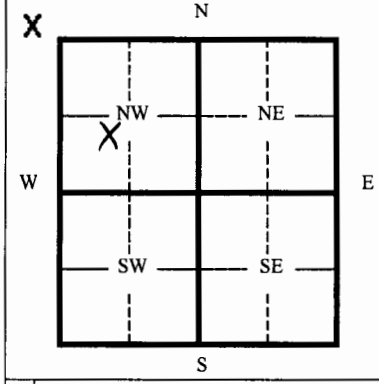

4 DEPTH OF WELL **38** ft.

WELL'S STATIC WATER LEVEL **Unknown** ft.

- WELL WAS USED AS:
- |              |                              |                           |
|--------------|------------------------------|---------------------------|
| 1 Domestic   | 5 Public Water Supply        | 9 Dewatering              |
| 2 Irrigation | 6 Oil Field Water Supply     | 10 <b>Monitoring Well</b> |
| 3 Feedlot    | 7 Lawn and Garden (domestic) | 11 Injection Well         |
| 4 Industrial | 8 Air Conditioning           | 12 Other                  |

Was a chemical/bacteriological sample submitted to Department? Yes No **X**

If yes, mo/day/yr sample was submitted

Water Well Disinfected: Yes No **X**

5 TYPE OF BLANK CASING USED:

1 Steel	3 RMP (SR)	5 Wrought	7 Fiberglass	9 Other (specify below)
2 <b>PVC</b>	4 ABC	6 Asbestos-Cement	8 Concrete Tile	

Blank casing diameter **2** in. Was casing pulled? Yes **X** No If yes, how much **3** ft.

Casing height above or below land surface **0** in.

6 GROUT PLUG MATERIAL: 1 Neat cement 2 Cement grout **3 Bentonite** 4 Other

Grout Plug Intervals From **0** ft. to **38** ft. From ft. to ft. From ft. to ft.

- What is the nearest source of possible contamination:
- |                          |                   |                         |                          |
|--------------------------|-------------------|-------------------------|--------------------------|
| 1 Septic tank            | 6 Seepage pit     | 11 <b>Fuel storage</b>  | 16 Other (specify below) |
| 2 Sewer lines            | 7 Pit privy       | 12 Fertilizer storage   |                          |
| 3 Watertight sewer lines | 8 Sewage lagoon   | 13 Insecticide storage  |                          |
| 4 Lateral lines          | 9 Feedyard        | 14 Abandoned water well |                          |
| 5 Cess Pool              | 10 Livestock pens | 15 Oil well/ Gas well   |                          |

Direction from well? **Unknown** How many feet? **Unknown**

FROM	TO	CODE	PLUGGING MATERIALS
0	38		Bentonite Grout

7 CONTRACTOR'S OR LANDOWNER'S CERTIFICATION: This water well was plugged under my jurisdiction and was completed on (mo/day/yr) **3/21/05 to 3/25/05** and this record is true to the best of my knowledge and belief. Kansas Water Well Contractor's License No. **616** This Water Well Record was completed on (mo/day/yr) **5/24/05** under the business name of **Thiele Geotech, Inc.**

by (signature) *D. J. Hall*

INSTRUCTIONS: Please fill in blanks and circle the correct answers. Send three copies to Kansas Department of Health and Environment, Bureau of Water, Topeka, Kansas 66620-0001. Telephone: 785-296-3565. Send one to Water Well Owner and retain one for your records.