

2-45-3

WATER WELL PLUGGING RECORD

FORM WWC-5P

KSA 82a-1212

UMW-4

1 LOCATION OF WATER WELL:	Fraction	Section Number	Township Number	Range Number
County: Mcpherson	SW ¼ SE ¼ NW ¼	26	19S	3W

Distance and direction from nearest town or city street address of well if located within city?

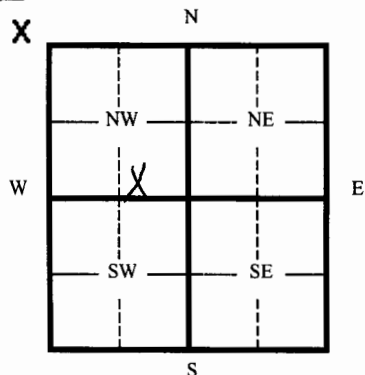
2201 E. Kansas Avenue2 WATER WELL OWNER: **ATOFINA Petrochemicals, Inc.**RR#, St. Address, Box # **P.O. Box 674411**

Board of Agriculture, Division of Water Resources

City, State, ZIP Code : **Houston, Texas 77267-4411**

Application Number:

3 MARK WELL'S LOCATION WITH AN "X" IN SECTION BOX:

4 DEPTH OF WELL **45** ft.WELL'S STATIC WATER LEVEL **Unknown** ft.

WELL WAS USED AS:

- | | | |
|--------------|------------------------------|--------------------|
| 1 Domestic | 5 Public Water Supply | 9 Dewatering |
| 2 Irrigation | 6 Oil Field Water Supply | 10 Monitoring Well |
| 3 Feedlot | 7 Lawn and Garden (domestic) | 11 Injection Well |
| 4 Industrial | 8 Air Conditioning | 12 Other |

Was a chemical/bacteriological sample submitted to Department? Yes No **X**

If yes, mo/day/yr sample was submitted

Water Well Disinfected: Yes No **X**

5 TYPE OF BLANK CASING USED:

- | | | | | |
|--------------|------------|-------------------|-----------------|-------------------------|
| 1 Steel | 3 RMP (SR) | 5 Wrought | 7 Fiberglass | 9 Other (specify below) |
| 2 PVC | 4 ABC | 6 Asbestos-Cement | 8 Concrete Tile | |

Blank casing diameter **2** in. Was casing pulled? Yes **x** No If yes, how much **3** ft.Casing height above or below land surface **0** in.6 GROUT PLUG MATERIAL: 1 Neat cement 2 Cement grout **3 Bentonite** 4 OtherGrout Plug Intervals From **0** ft. to **45** ft. From ft. to ft. From ft. to ft.

What is the nearest source of possible contamination:

- | | | | |
|--------------------------|-------------------|-------------------------|--------------------------|
| 1 Septic tank | 6 Seepage pit | 11 Fuel storage | 16 Other (specify below) |
| 2 Sewer lines | 7 Pit privy | 12 Fertilizer storage | |
| 3 Watertight sewer lines | 8 Sewage lagoon | 13 Insecticide storage | |
| 4 Lateral lines | 9 Feedyard | 14 Abandoned water well | |
| 5 Cess Pool | 10 Livestock pens | 15 Oil well/ Gas well | |

Direction from well? **Unknown**How many feet? **Unknown**

FROM	TO	CODE	PLUGGING MATERIALS
0	45		Bentonite Grout

7 CONTRACTOR'S OR LANDOWNER'S CERTIFICATION: This water well was plugged under my jurisdiction and was completed on (mo/day/yr) **3/21/05 to 3/25/05** and this record is true to the best of my knowledge and belief. Kansas Water Well Contractor's License No. **616** This Water Well Record was completed on (mo/day/yr) **5/24/05** under the business name of **Thiele Geotech, Inc.**

by (signature) *D. J. [Signature]*

INSTRUCTIONS: Please fill in blanks and circle the correct answers. Send three copies to Kansas Department of Health and Environment, Bureau of Water, Topeka, Kansas 66620-0001. Telephone: 785-296-3565. Send one to Water Well Owner and retain one for your records.