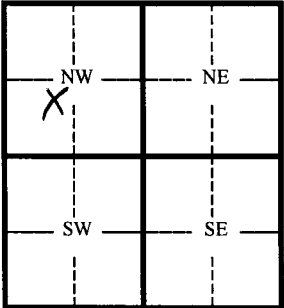


|   |                |                 |              |
|---|----------------|-----------------|--------------|
| 1 LOCATION OF WATER WELL: Fraction            | Section Number | Township Number | Range Number |
| County: <b>Mcpherson</b> NE 1/4 SW 1/4 NW 1/4 | <b>26</b>      | <b>19S</b>      | <b>3W</b>    |

Distance and direction from nearest town or city street address of well if located within city?  
**2201 E. Kansas Avenue**

|  |  |
|--|--|
| 2 WATER WELL OWNER: <b>ATOFINA Petrochemicals, Inc.</b>  | Board of Agriculture, Division of Water Resources<br>Application Number: |
| RR#, St. Address, Box # <b>P.O. Box 674411</b>           |  |
| City, State, ZIP Code : <b>Houston, Texas 77267-4411</b> |  |

|  |  |                       |                       |              |              |                          |                    |           |                              |                   |              |                    |                 |
|--|--|-----------------------|-----------------------|--------------|--------------|--------------------------|--------------------|-----------|------------------------------|-------------------|--------------|--------------------|-----------------|
| 3 MARK WELL'S LOCATION WITH AN "X" IN SECTION BOX:   | 4 DEPTH OF WELL <b>20</b> ft.  |                       |                       |              |              |                          |                    |           |                              |                   |              |                    |                 |
| <div style="text-align: center;">N<br/>W      E<br/>S</div>  | WELL'S STATIC WATER LEVEL <b>Unknown</b> ft.   |                       |                       |              |              |                          |                    |           |                              |                   |              |                    |                 |
|  | WELL WAS USED AS:  |                       |                       |              |              |                          |                    |           |                              |                   |              |                    |                 |
|  | <table border="0"><tr><td>1 Domestic</td><td>5 Public Water Supply</td><td>9 Dewatering</td></tr><tr><td>2 Irrigation</td><td>6 Oil Field Water Supply</td><td>10 Monitoring Well</td></tr><tr><td>3 Feedlot</td><td>7 Lawn and Garden (domestic)</td><td>11 Injection Well</td></tr><tr><td>4 Industrial</td><td>8 Air Conditioning</td><td>12 <b>Other</b></td></tr></table> | 1 Domestic            | 5 Public Water Supply | 9 Dewatering | 2 Irrigation | 6 Oil Field Water Supply | 10 Monitoring Well | 3 Feedlot | 7 Lawn and Garden (domestic) | 11 Injection Well | 4 Industrial | 8 Air Conditioning | 12 <b>Other</b> |
|  | 1 Domestic   | 5 Public Water Supply | 9 Dewatering          |              |              |                          |                    |           |                              |                   |              |                    |                 |
| 2 Irrigation   | 6 Oil Field Water Supply   | 10 Monitoring Well    |                       |              |              |                          |                    |           |                              |                   |              |                    |                 |
| 3 Feedlot  | 7 Lawn and Garden (domestic)   | 11 Injection Well     |                       |              |              |                          |                    |           |                              |                   |              |                    |                 |
| 4 Industrial   | 8 Air Conditioning   | 12 <b>Other</b>       |                       |              |              |                          |                    |           |                              |                   |              |                    |                 |
| Was a chemical/bacteriological sample submitted to Department? Yes ___ No <b>X</b>   |  |                       |                       |              |              |                          |                    |           |                              |                   |              |                    |                 |
| If yes, mo/day/yr sample was submitted _____   |  |                       |                       |              |              |                          |                    |           |                              |                   |              |                    |                 |
| Water Well Disinfected: Yes ___ No <b>X</b>  |  |                       |                       |              |              |                          |                    |           |                              |                   |              |                    |                 |

|   |
|---|
| 5 TYPE OF BLANK CASING USED:  |
| 1 Steel      3 RMP (SR)      5 Wrought      7 Fiberglass      9 Other (specify below)                   |
| 2 <b>PVC</b> 4 ABC      6 Asbestos-Cement      8 Concrete Tile  |
| Blank casing diameter <b>4</b> in. Was casing pulled? Yes <b>X</b> No ___ If yes, how much <b>3 ft.</b> |
| Casing height above or below land surface <b>0</b> in.  |

|  |                               
|--|-------------------------------|-------------------------|--------------------------|--------------------------|---------------|-------------|-----------------------|--|--------------------------|-----------------|------------------------|--|-----------------|------------|-------------------------|--|-------------|-------------------|-----------------------|--|
| 6 GROUT PLUG MATERIAL: 1 Neat cement      2 Cement grout      3 <b>Bentonite</b> 4 Other   |                               |                         
| Grout Plug Intervals From <b>0</b> ft. to <b>20</b> ft. From _____ ft. to _____ ft. From _____ ft. to _____ ft.  |                               |                         
| What is the nearest source of possible contamination:  |                               |                         
| <table border="0"><tr><td>1 Septic tank</td><td>6 Seepage pit</td><td>11 <b>Fuel storage</b></td><td>16 Other (specify below)</td></tr><tr><td>2 Sewer lines</td><td>7 Pit privy</td><td>12 Fertilizer storage</td><td></td></tr><tr><td>3 Watertight sewer lines</td><td>8 Sewage lagoon</td><td>13 Insecticide storage</td><td></td></tr><tr><td>4 Lateral lines</td><td>9 Feedyard</td><td>14 Abandoned water well</td><td></td></tr><tr><td>5 Cess Pool</td><td>10 Livestock pens</td><td>15 Oil well/ Gas well</td><td></td></tr></table> | 1 Septic tank                 | 6 Seepage pit           | 11 <b>Fuel storage</b>   | 16 Other (specify below) | 2 Sewer lines | 7 Pit privy | 12 Fertilizer storage |  | 3 Watertight sewer lines | 8 Sewage lagoon | 13 Insecticide storage |  | 4 Lateral lines | 9 Feedyard | 14 Abandoned water well |  | 5 Cess Pool | 10 Livestock pens | 15 Oil well/ Gas well |  |
| 1 Septic tank  | 6 Seepage pit                 | 11 <b>Fuel storage</b>  | 16 Other (specify below) |                          |               |             |                       |  |                          |                 |                        |  |                 |            |                         |  |             |                   |                       |  |
| 2 Sewer lines  | 7 Pit privy                   | 12 Fertilizer storage   |                          |                          |               |             |                       |  |                          |                 |                        |  |                 |            |                         |  |             |                   |                       |  |
| 3 Watertight sewer lines   | 8 Sewage lagoon               | 13 Insecticide storage  |                          |                          |               |             |                       |  |                          |                 |                        |  |                 |            |                         |  |             |                   |                       |  |
| 4 Lateral lines  | 9 Feedyard                    | 14 Abandoned water well |                          |                          |               |             |                       |  |                          |                 |                        |  |                 |            |                         |  |             |                   |                       |  |
| 5 Cess Pool  | 10 Livestock pens             | 15 Oil well/ Gas well   |                          |                          |               |             |                       |  |                          |                 |                        |  |                 |            |                         |  |             |                   |                       |  |
| Direction from well? <b>Unknown</b>  | How many feet? <b>Unknown</b> |                         |                          |                          |               |             |                       |  |                          |                 |                        |  |                 |            |                         |  |             |                   |                       |  |

| FROM | TO | CODE | PLUGGING MATERIALS |
|------|----|------|--------------------|
| 0    | 20 |      | Bentonite Grout    |
|      |    |      |                    |
|      |    |      |                    |
|   |
|---|
| 7 CONTRACTOR'S OR LANDOWNER'S CERTIFICATION: This water well was plugged under my jurisdiction and was completed on (mo/day/yr) <b>3/21/05 to 3/25/05</b> and this record is true to the best of my knowledge and belief. Kansas Water Well Contractor's License No. <b>616</b> This Water Well Record was completed on (mo/day/yr) <b>5/31/05</b> under the business name of <b>Thiele Geotech, Inc.</b> |
| by (signature) <i>Dennis J. Anderson</i>  |

INSTRUCTIONS: Please fill in blanks and circle the correct answers. Send three copies to Kansas Department of Health and Environment, Bureau of Water, Topeka, Kansas 66620-0001. Telephone: 785-296-3565. Send one to Water Well Owner and retain one for your records.