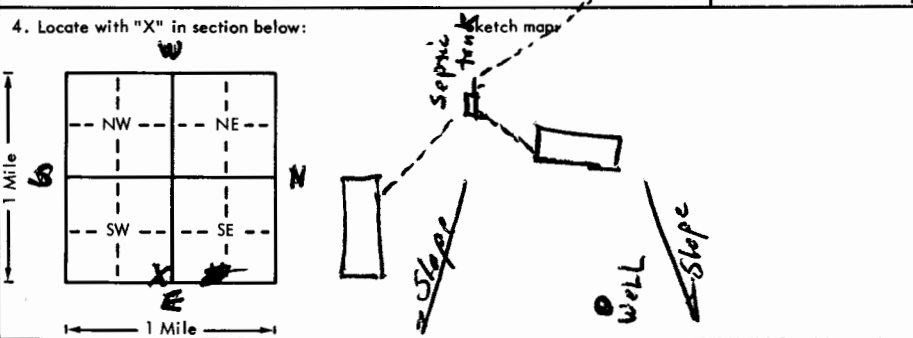


USE TYPEWRITER OR BALL
POINT PEN-PRESS FIRMLY,
PRINT CLEARLY.

WATER WELL RECORD
KSA 82a-1201-1215

Kansas Department of Health and
Environment-Division of Environment
(Water well Contractors)
Topeka, Kansas 66620

1. Location of well:		County McPherson	Fraction SE 1/4 SE 1/4 SW 1/4	Section number 19	Township number T 19 S	Range number R 3 E W
2. Distance and direction from nearest town or city: Street address of well location if in city:		0.6 mile West of McPherson		3. Owner of well: R.R. or street: City, state, zip code:		
				BILL ANDREAS RR #2 McPherson, KNS 67460		
4. Locate with "X" in section below:				6. Bore hole dia. 12 in. Completion date _____ Well depth 105 ft.		
				7. <input checked="" type="checkbox"/> Cable tool <input checked="" type="checkbox"/> Rotary <input type="checkbox"/> Driven <input type="checkbox"/> Dug <input type="checkbox"/> Hollow rod <input type="checkbox"/> Jetted <input type="checkbox"/> Bored <input type="checkbox"/> Reverse rotary		
5. Type and color of material				8. Use: <input checked="" type="checkbox"/> Domestic <input type="checkbox"/> Public supply <input type="checkbox"/> Industry <input type="checkbox"/> Irrigation <input type="checkbox"/> Air conditioning <input type="checkbox"/> Stock <input type="checkbox"/> Lawn <input type="checkbox"/> Oil field water <input type="checkbox"/> Other		
				9. Casing: Material plastic Height: Above or below Threaded <input type="checkbox"/> Welded <input type="checkbox"/> Surface 12 in. RMP <input type="checkbox"/> PVC <input checked="" type="checkbox"/> Weight _____ lbs./ft. Dia. 6 in. to 105 ft. depth Wall Thickness: inches or Dia. _____ in. to _____ ft. depth gage No. _____		
				10. Screen: Manufacturer's name Cert-tel - Own Slot Type PVC Dia. 6 in. Slot/gauze 0.064 Length 30 ft. Set between 85 ft. and 105 ft. ft. and _____ ft. Gravel pack? <input checked="" type="checkbox"/> Size range of material 10-14		
				11. Static water level: _____ mo./day/yr. 75 ft. below land surface Date _____		
				12. Pumping level below land surfaces: 26 ft. after 2 hrs. pumping 20 g.p.m. _____ ft. after _____ hrs. pumping _____ g.p.m. Estimated maximum yield _____ g.p.m.		
				13. Water sample submitted: _____ mo./day/yr. Yes <input checked="" type="checkbox"/> No <input type="checkbox"/> Date _____		
				14. Well head completion: _____ Pitless adapter 12 inches above grade		
				15. Well grouted? by owner With: _____ Neat cement _____ Bentonite _____ Concrete Depth: From _____ ft. to _____ ft.		
				16. Nearest source of possible contamination: Septic ft. 96 Direction West Type tonk Well disinfected upon completion? <input checked="" type="checkbox"/> Yes <input type="checkbox"/> No		
				17. Pump: <input checked="" type="checkbox"/> Not installed Manufacturer's name _____ Model number _____ HP _____ Volts _____ Length of drop pipe _____ ft. capacity _____ g.p.m. Type: <input type="checkbox"/> Submersible <input type="checkbox"/> Turbine <input type="checkbox"/> Jet <input type="checkbox"/> Reciprocating <input type="checkbox"/> Centrifugal <input type="checkbox"/> Other		
(Use a second sheet if needed)						
18. Elevation:		19. Remarks:		20. Water well contractor's certification:		
Topography: <input type="checkbox"/> Hill <input type="checkbox"/> Slope <input type="checkbox"/> Upland <input type="checkbox"/> Valley		Customer is Aware of Installation Requirements William Andreas		This well was drilled under my jurisdiction and this report is true to the best of my knowledge and belief. PAUL'S INC 125 Business name _____ License No. _____ Address Box 26 - Hesston Signed Paul Paulhus Date 3/29/76 Authorized representative		

17-30 19 SE SE SW
T
R
Sec
1/4 1/4 1/4