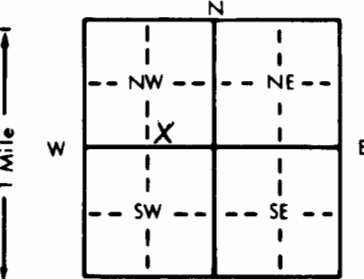


1 LOCATION OF WATER WELL:		Fraction		Township Number		Range Number	
County: McPHERSON		S/W 1/4 S/E 1/4 N/W 1/4		26		T 19 S R 3 EW	
Distance and direction from nearest town or city street address of well if located within city?							
2201 E. KANSAS AVE. MCPHERSON KANSAS 67460							
2 WATER WELL OWNER: Fina Oil & Chemical Co.							
RR#, St. Address, Box #: P.O. BOX 2159							
City, State, ZIP Code: Dallas Tx. 75221							
Board of Agriculture, Division of Water Resources							
Application Number:							
3 LOCATE WELL'S LOCATION WITH AN "X" IN SECTION BOX:				4 DEPTH OF COMPLETED WELL: 41.0 ft. ELEVATION:			
				Depth(s) Groundwater Encountered 1.36.6 ft. 2. ft. 3. ft.			
				WELL'S STATIC WATER LEVEL 36.6 ft. below land surface measured on mo/day/yr			
				Pump test data: Well water was ft. after hours pumping gpm			
				Est. Yield gpm: Well water was ft. after hours pumping gpm			
				Bore Hole Diameter 7 1/4 in. to 41.0 ft., and in. to ft.			
				WELL WATER TO BE USED AS: 5 Public water supply 8 Air conditioning 11 Injection well			
				1 Domestic 3 Feedlot 6 Oil field water supply 9 Dewatering 12 Other (Specify below)			
				2 Irrigation 4 Industrial 7 Lawn and garden only 10 Monitoring well air sparge			
				Was a chemical/bacteriological sample submitted to Department? Yes No; If yes, mo/day/yr sample was submitted			
				Water Well Disinfected? Yes No			
5 TYPE OF BLANK CASING USED:							
1 Steel 3 RMP (SR) 5 Wrought iron 8 Concrete tile CASING JOINTS: Glued Clamped							
2 PVC 4 ABS 6 Asbestos-Cement 9 Other (specify below) Welded							
3 Fiberglass Threaded							
Blank casing diameter 2 in. to 39 ft., Dia. in. to ft., Dia. in. to ft.							
Casing height above land surface in., weight sched 40 lbs./ft. Wall thickness or gauge No.							
TYPE OF SCREEN OR PERFORATION MATERIAL:							
1 Steel 3 Stainless steel 5 Fiberglass 8 RMP (SR) 10 Asbestos-cement							
2 Brass 4 Galvanized steel 6 Concrete tile 9 ABS 11 Other (specify)							
12 None used (open hole)							
SCREEN OR PERFORATION OPENINGS ARE:							
1 Continuous slot 3 Mill slot 5 Gauzed wrapped 8 Saw cut 11 None (open hole)							
2 Louvered shutter 4 Key punched 6 Wire wrapped 9 Drilled holes							
7 Torch cut 10 Other (specify)							
SCREEN-PERFORATED INTERVALS: From 39 ft. to 41 ft., From ft. to ft.							
GRAVEL PACK INTERVALS: From 41 ft. to 37 ft., From ft. to ft.							
From ft. to ft., From ft. to ft.							
6 GROUT MATERIAL: 1 Neat cement 2 Cement grout 3 Bentonite 4 Other							
Grout Intervals: From 38 ft. to 0.6 ft., From ft. to ft., From ft. to ft.							
What is the nearest source of possible contamination:							
1 Septic tank 4 Lateral lines 7 Pit privy 10 Livestock pens 14 Abandoned water well							
2 Sewer lines 5 Cess pool 8 Sewage lagoon 11 Fuel storage 15 Oil well/Gas well							
3 Watertight sewer lines 6 Seepage pit 9 Feedyard 12 Fertilizer storage 16 Other (specify below)							
13 Insecticide storage							
Direction from well? N/E How many feet? 104							
FROM TO LITHOLOGIC LOG FROM TO PLUGGING INTERVALS							
0 0.6 concrete							
0.6 2.0 topsoil							
2.0 25.0 stiff brn. clay							
25.0 36.0 stiff tan clay w/ silty layers							
36.0 41.0 sandy silty saterated at 36.6							
7 CONTRACTOR'S OR LANDOWNER'S CERTIFICATION: This water well was (1) constructed, (2) reconstructed, or (3) plugged under my jurisdiction and was completed on (mo/day/year) 3-14-94 and this record is true to the best of my knowledge and belief. Kansas Water Well Contractor's License No. 517. This Water Well Record was completed on (mo/day/yr) 4-11-94 under the business name of GROUNDWATER TECHNOLOGY by (signature)							
INSTRUCTIONS: Use typewriter or ball point pen. PLEASE PRESS FIRMLY and PRINT clearly. Please fill in blanks, underline or circle the correct answers. Send top three copies to Kansas Department of Health and Environment, Bureau of Water, Topeka, Kansas 66620-0001. Telephone: 913-296-5545. Send one to WATER WELL OWNER and retain one for your records.							