


1 LOCATION OF WATER WELL: Fraction NE 1/4 SW 1/4 NW 1/4 Section Number 26 Township Number T 19 S Range Number R 3 EW

Distance and direction from nearest town or city street address of well if located within city?  
50' West, 2201 E. Kansas; McPherson, KS 40875009 MW-5

2 WATER WELL OWNER: FINA  
RR#, St. Address, Box #: P.O. Box 2159 Board of Agriculture, Division of Water Resources  
City, State, ZIP Code: Dallas, TX 75221 Application Number:

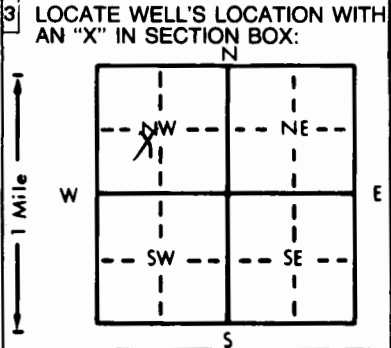

4 DEPTH OF COMPLETED WELL: 11.5 ft. ELEVATION: Approx. Surface 1494  
Depth(s) Groundwater Encountered 1. ft. 2. ft. 3. ft.  
WELL'S STATIC WATER LEVEL: ft. below land surface measured on mo/day/yr  
Pump test data: Well water was ft. after hours pumping gpm  
Est. Yield N/A gpm: Well water was ft. after hours pumping gpm  
Bore Hole Diameter: 12 in. to 12 ft., and in. to ft.  
WELL WATER TO BE USED AS:  
5 Public water supply 8 Air conditioning 11 Injection well  
1 Domestic 3 Feedlot 6 Oil field water supply 9 Dewatering 12 Other (Specify below)  
2 Irrigation 4 Industrial 7 Lawn and garden only 10 Observation well  
Was a chemical/bacteriological sample submitted to Department? Yes No X; If yes, mo/day/yr sample was submitted  
Water Well Disinfected? Yes No X

5 TYPE OF BLANK CASING USED:  
1 Steel 3 RMP (SR) 5 Wrought iron 8 Concrete tile CASING JOINTS: Glued Clamped  
2 PVC 4 ABS 6 Asbestos-Cement 9 Other (specify below) Welded  
7 Fiberglass Threaded X  
Blank casing diameter 4 in. to 6 ft., Dia. in. to ft., Dia. in. to ft.  
Casing height above land surface -2 in., weight lbs./ft. Wall thickness or gauge No. Schedule 40  
TYPE OF SCREEN OR PERFORATION MATERIAL:  
1 Steel 3 Stainless steel 5 Fiberglass 8 RMP (SR) 10 Asbestos-cement  
2 Brass 4 Galvanized steel 6 Concrete tile 9 ABS 11 Other (specify)  
12 None used (open hole)  
SCREEN OR PERFORATION OPENINGS ARE:  
1 Continuous slot 2 Mill slot 3 Gauzed wrapped 4 Saw cut 5 None (open hole)  
2 Louvered shutter 4 Key punched 7 Wire wrapped 9 Drilled holes  
7 Torch cut 10 Other (specify)  
SCREEN-PERFORATED INTERVALS: From 6 ft. to 11 ft., From ft. to ft.  
GRAVEL PACK INTERVALS: From 5 ft. to 12 ft., From ft. to ft.

6 GROUT MATERIAL: 1 Neat cement 2 Cement grout 3 Bentonite 4 Other Vol. clay Grout  
Grout Intervals: From 3 ft. to 6 ft., From 0 ft. to 3 ft., From ft. to ft.  
What is the nearest source of possible contamination:  
1 Septic tank 4 Lateral lines 7 Pit privy 10 Livestock pens 14 Abandoned water well  
2 Sewer lines 5 Cess pool 8 Sewage lagoon 11 Fuel storage 15 Oil well/Gas well  
3 Watertight sewer lines 6 Seepage pit 9 Feedyard 12 Fertilizer storage 16 Other (specify below)  
13 Insecticide storage  
Direction from well? North and South How many feet? 3

FROM	TO	LITHOLOGIC LOG	FROM	TO	LITHOLOGIC LOG
0	11.5	Brown Fine to Coarse Sand and Clay (F111)			
11.5	12	Red-Brown Clay			

7 CONTRACTOR'S OR LANDOWNER'S CERTIFICATION: This water well was (1) constructed, (2) reconstructed, or (3) plugged under my jurisdiction and was completed on (mo/day/year) 4/23/87 and this record is true to the best of my knowledge and belief. Kansas Water Well Contractor's License No. 416 This Water Well Record was completed on (mo/day/yr) 12-10-87 under the business name of TOMCON CONSULTANTS INC by (signature) [Signature]

INSTRUCTIONS: Use typewriter or ball point pen. PLEASE PRESS FIRMLY and PRINT clearly. Please fill in blanks, underline or circle the correct answers. Send top three copies to Kansas Department of Health and Environment, Office of Oil Field and Environmental Geology, Regulation and Permitting Section, Topeka, Kansas 66620-7500, Telephone: 913-862-9360. Send one to WATER WELL OWNER and retain one for your records.