


1 LOCATION OF WATER WELL: County: McPherson	Fraction SW 1/4 SE 1/4 NW 1/4	Section Number 26	Township Number T 19 S	Range Number R 3 E
--	----------------------------------	----------------------	---------------------------	-----------------------

2	WATER WELL OWNER: FINA Oil and Chemical Company	
	RR#, St. Address, Box # : P.O. Box 2159	Board of Agriculture, Division of Water Resources
	City, State, ZIP Code : Dallas, TX 75221	Application Number:

	N	
T	1	1

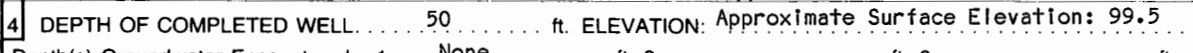

	Pump test data:	Well water was	ft. after	hours pumping	gpm
Est. Yield	N/A	gpm: Well water was	ft. after	hours pumping	gpm

WELL WATER TO BE USED AS:		5 Public water supply	8 Air conditioning	11 Injection well
1 Domestic	3 Feedlot	6 Oil field water supply	9 Dewatering	12 Other (Specify below)

Water Well Disinfected? Yes No X

1 Steel	3 RMP (SR)	6 Asbestos-Cement	9 Other (specify below)	Welded
2 PVC	4 ABS	7 Fiberglass		Threaded . . . X

TYPE OF SCREEN OR PERFORATION MATERIAL: 7 PVC 10 Asbestos-cement

SCREEN OR PERFORATION OPENINGS ARE:

1 Continuous slot	3 Mill slot	5 Gauzed wrapped	8 Saw cut	11 None (open hole)
		6 Wire wrapped	9 Drilled holes	

SCREEN-PERFORATED INTERVALS: From 55 ft. to 50 ft., From ft. to ft.
From ft. to ft., From ft. to ft.

		From	ft. to	ft., From	ft. to	ft.
6	GROUT MATERIAL:	1 Neat cement	2 Cement grout	3 Bentonite	4 Other	

1 Septic tank	4 Lateral lines	7 Pit privy	10 Livestock pens	14 Hand-dug water well

Direction from well?			How many feet?		
FROM	TO	LITHOLOGIC LOG	FROM	TO	PLUGGING INTERVALS

[illegible]

Water Well Contractor's License No. 416 This Water Well Record was completed on (mo/day/yr) 10/14/92
under the business name of Terracon Consultants, Inc. by (signature) Steve Fischer

INSTRUCTIONS: Use typewriter or ball point pen. PLEASE PRESS FIRMLY and PRINT clearly. Please fill in blanks, underline or circle the correct answers. Send top three copies to Kansas Department of Health and Environment, Bureau of Water, Topeka, Kansas 66620-0001. Telephone: 913-296-5545. Send one to WATER WELL OWNER and retain one for your records.