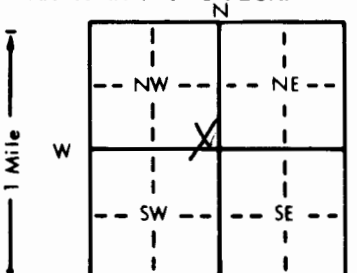


1 LOCATION OF WATER WELL: County: <u>McPherson</u>	Fraction <u>SE 1/4 SE 1/4 NW 1/4</u>	Section Number <u>29</u>	Township Number T <u>19</u> S	Range Number R <u>3</u> E <u>10</u>
---	---	-----------------------------	----------------------------------	--

Distance and direction from nearest town or city street address of well if located within city?

RT 56 800 W. Kansas Ave, McPherson KS

2 WATER WELL OWNER: <u>Kerr-McGee Corp</u> RR#, St. Address, Box #: <u>123 Rof. S. Kerr Ave</u> City, State, ZIP Code: <u>Oklahoma City OK</u>	Board of Agriculture, Division of Water Resources Application Number:
--	--

3 LOCATE WELL'S LOCATION WITH AN "X" IN SECTION BOX: 	4 DEPTH OF COMPLETED WELL: <u>50.5</u> ft. ELEVATION: <u>CA 1495</u> Depth(s) Groundwater Encountered 1. <u>None</u> ft. 2. <u>None</u> ft. 3. <u>None</u> ft. WELL'S STATIC WATER LEVEL <u>None</u> ft. below land surface measured on mo/day/yr Pump test data: Well water was <u>None</u> ft. after <u>None</u> hours pumping <u>None</u> gpm Est. Yield <u>None</u> gpm: Well water was <u>None</u> ft. after <u>None</u> hours pumping <u>None</u> gpm Bore Hole Diameter <u>8"</u> in. to <u>None</u> ft., and <u>None</u> in. to <u>None</u> ft. WELL WATER TO BE USED AS: 1 Domestic 3 Feedlot 6 Oil field water supply 8 Air conditioning 11 Injection well 2 Irrigation 4 Industrial 7 Lawn and garden only 9 Dewatering 12 Other (Specify below) <u>test well</u> Was a chemical/bacteriological sample submitted to Department? Yes <u>None</u> No <u>None</u> ; If yes, mo/day/yr sample was submitted <u>None</u> Water Well Disinfected? Yes <u>None</u>
--	---

5 TYPE OF BLANK CASING USED: 1 Steel <u>2 PVC</u> Blank casing diameter <u>2</u> in. to <u>30</u> ft., Dia <u>30</u> in. to <u>None</u> ft., Dia Casing height above land surface <u>None</u> in., weight <u>None</u> lbs./ft. Wall thickness or gauge No. <u>None</u> TYPE OF SCREEN OR PERFORATION MATERIAL: 1 Steel 3 Stainless steel 5 Fiberglass 7 PVC 2 Brass 4 Galvanized steel 6 Concrete tile 8 RMP (SR) SCREEN OR PERFORATION OPENINGS ARE: <u>1020</u> 1 Continuous slot <u>3 Mill slot</u> 6 Wire wrapped 9 Drilled holes 2 Louvered shutter 4 Key punched 7 Torch cut 10 Other (specify) <u>None</u> SCREEN-PERFORATED INTERVALS: From <u>47.2</u> ft. to <u>22.2</u> ft., From <u>None</u> ft. to <u>None</u> ft., From <u>None</u> ft. to <u>None</u> ft. GRAVEL PACK INTERVALS: From <u>50.5</u> ft. to <u>23</u> ft., From <u>None</u> ft. to <u>None</u> ft., From <u>None</u> ft. to <u>None</u> ft.	5 Wrought iron 8 Concrete tile CASING JOINTS: Glued <u>None</u> Clamped <u>None</u> 6 Asbestos-Cement 9 Other (specify below) <u>Threaded</u> 7 Fiberglass 10 Asbestos-cement 11 Other (specify) <u>None</u> 12 None used (open hole) 8 Saw cut 11 None (open hole) 9 Drilled holes 10 Other (specify) <u>None</u>
---	--

6 GROUT MATERIAL: 1 Neat cement 2 Cement grout 3 Bentonite 4 Other Grout Intervals: From <u>19.5</u> ft. to <u>1.0</u> ft., From <u>None</u> ft. to <u>None</u> ft., From <u>None</u> ft. to <u>None</u> ft. What is the nearest source of possible contamination: 1 Septic tank 4 Lateral lines 7 Pit privy 10 Livestock pens 14 Abandoned water well 2 Sewer lines 5 Cess pool 8 Sewage lagoon 11 Fuel storage 15 Oil well/Gas well 3 Watertight sewer lines 6 Seepage pit 9 Feedyard 12 Fertilizer storage 16 Other (specify below) <u>None</u> 13 Insecticide storage Direction from well? <u>None</u> How many feet? <u>None</u>

FROM	TO	LITHOLOGIC LOG	FROM	TO	PLUGGING INTERVALS
0	6.0	<u>DARK SILTY CLAY</u>			
6.0	17.0	<u>BR to TAN SILTY SANDY CLAY</u>			
17.0	21.0	<u>TAN SANDY SILT</u>			
21.0	30.0	<u>TAN SILTY SAND</u>			
30.0	50.0	<u>TAN FINE SAND</u>			

7 CONTRACTOR'S OR LANDOWNER'S CERTIFICATION: This water well was (1) constructed, (2) reconstructed, or (3) plugged under my jurisdiction and was completed on (mo/day/year) <u>April 13, 1990</u> and this record is true to the best of my knowledge and belief. Kansas Water Well Contractor's License No. <u>None</u> This Water Well Record was completed on (mo/day/yr) <u>None</u> under the business name of <u>None</u> by (signature) <u>Samuel D. Knight</u>
