


1 LOCATION OF WATER WELL:	Fraction	Section Number	Township Number	Range Number
County: <u>McPherson</u>	<u>NW 1/4 NW 1/4 SW 1/4</u>	<u>29</u>	T <u>19</u> S	R <u>3</u> E/W

Distance and direction from nearest town or city street address of well if located within city?

1035 W. Kansas, McPherson

2 WATER WELL OWNER:	Board of Agriculture, Division of Water Resources
RR#, St. Address, Box #:	Application Number:
<u>Coastal Mart, Inc.</u>	
<u>9 Greenway Plaza</u>	
City, State, ZIP Code:	
<u>Houston, TX 77046</u>	

3 LOCATE WELL'S LOCATION WITH AN "X" IN SECTION BOX:	4 DEPTH OF COMPLETED WELL: <u>90</u> ft. ELEVATION: <u>1486.53</u>
--	--

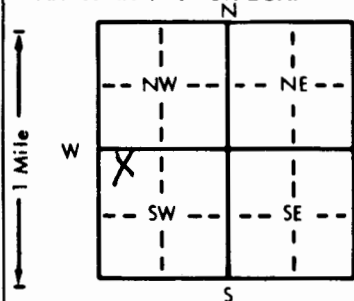

Depth(s) Groundwater Encountered 1. ft. 2. ft. 3. ft.

WELL'S STATIC WATER LEVEL 76.5 ft. below land surface measured on mo/day/yr 3-2-94

Pump test data: Well water was ft. after hours pumping gpm

Est. Yield gpm; Well water was ft. after hours pumping gpm

Bore Hole Diameter: 6.25 in. to ft., and in. to ft.

WELL WATER TO BE USED AS:

- | | | | | |
|--------------|--------------|--------------------------|--------------------|--------------------------|
| 1 Domestic | 3 Feedlot | 6 Oil field water supply | 9 Dewatering | 11 Injection well |
| 2 Irrigation | 4 Industrial | 7 Lawn and garden only | 10 Monitoring well | 12 Other (Specify below) |

Was a chemical/bacteriological sample submitted to Department? Yes No X; If yes, mo/day/yr sample was submittedWater Well Disinfected? Yes No X

5 TYPE OF BLANK CASING USED:	5 Wrought iron	8 Concrete tile	CASING JOINTS: Glued Clamped
------------------------------	----------------	-----------------	--

- | | | | | |
|---------|------------|-------------------|-------------------------|----------------|
| 1 Steel | 3 RMP (SR) | 6 Asbestos-Cement | 9 Other (specify below) | Welded |
| 2 PVC | 4 ABS | 7 Fiberglass | | Threaded |

Blank casing diameter 2 in. to 64.5 ft., Dia. in. to ft., Dia. in. to ft.Casing height above land surface -0.34 in., weight lbs./ft. Wall thickness or gauge No.

TYPE OF SCREEN OR PERFORATION MATERIAL:

- | | | | | |
|---------|--------------------|-----------------|------------|--------------------------|
| 1 Steel | 3 Stainless steel | 5 Fiberglass | 7 RVC | 10 Asbestos-cement |
| 2 Brass | 4 Galvanized steel | 6 Concrete tile | 8 RMP (SR) | 11 Other (specify) |
| | | | 9 ABS | 12 None used (open hole) |

SCREEN OR PERFORATION OPENINGS ARE:

- | | | | | |
|--------------------|---------------|------------------|--------------------------|---------------------|
| 1 Continuous slot | 3 Mill slot | 5 Gauzed wrapped | 8 Saw cut | 11 None (open hole) |
| 2 Louvered shutter | 4 Key punched | 6 Wire wrapped | 9 Drilled holes | |
| | | 7 Torch cut | 10 Other (specify) | |

SCREEN-PERFORATED INTERVALS: From 64.5 ft. to 89.5 ft., From ft. to ft.

From ft. to ft., From ft. to ft.

GRAVEL PACK INTERVALS: From 60.6 ft. to 90 ft., From ft. to ft.

From ft. to ft., From ft. to ft.

6 GROUT MATERIAL:	1 Neat cement	2 Cement grout	3 Bentonite	4 Other
-------------------	---------------	----------------	-------------	---------------

Grout intervals: From 0 ft. to 60.6 ft., From ft. to ft., From ft. to ft.

What is the nearest source of possible contamination:

- | | | | | |
|--------------------------|-----------------|-----------------|------------------------|--------------------------|
| 1 Septic tank | 4 Lateral lines | 7 Pit privy | 10 Livestock pens | 14 Abandoned water well |
| 2 Sewer lines | 5 Cess pool | 8 Sewage lagoon | 11 Fuel storage | 15 Oil well/Gas well |
| 3 Watertight sewer lines | 6 Seepage pit | 9 Feedyard | 12 Fertilizer storage | 16 Other (specify below) |
| | | | 13 Insecticide storage | |

Direction from well? East

How many feet?

FROM	TO	LITHOLOGIC LOG	FROM	TO	PLUGGING INTERVALS
------	----	----------------	------	----	--------------------

0	0.7	Asphalt			
0.7	48	Brown, silty clay			
48	80	Brown, medium sand			
80	90	Brown, silty clay			