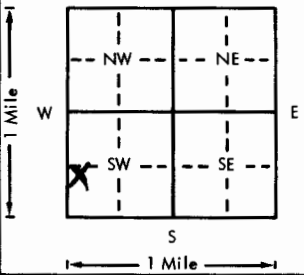


USE TYPEWRITER OR BALL
POINT PEN-PRESS FIRMLY,
PRINT CLEARLY.

WATER WELL RECORD
KSA 82a-1201-1215

Kansas Department of Health and
Environment-Division of Environment
(Water well Contractors)
Topeka, Kansas 66620

1. Location of well:	County Mcpherson	Fraction NW 1/4 SW 1/4 SW 1/4	Section number 30	Township number T 19 S	Range number R 3 E
2. Distance and direction from nearest town or city: 1W 1/4 N Street address of well location if in city: McPherson			3. Owner of well: Tom Harms R.R. or street: 1120 Hulse City, state, zip code: McPherson, Kansas		
4. Locate with "X" in section below: Sketch map: 			6. Bore hole dia. 9 in. Completion date 2-20-76 Well depth 135 ft.		
5. Type and color of material			7. <input checked="" type="checkbox"/> Cable tool <input checked="" type="checkbox"/> Rotary <input type="checkbox"/> Driven <input type="checkbox"/> Dug <input type="checkbox"/> Hollow rod <input type="checkbox"/> Jetted <input type="checkbox"/> Bored <input type="checkbox"/> Reverse rotary		
			8. Use: <input checked="" type="checkbox"/> Domestic <input type="checkbox"/> Public supply <input type="checkbox"/> Industry <input type="checkbox"/> Irrigation <input type="checkbox"/> Air conditioning <input type="checkbox"/> Stock <input type="checkbox"/> Lawn <input type="checkbox"/> Oil field water <input type="checkbox"/> Other		
			9. Casing: Material PVC Height: Above or below Threaded <input type="checkbox"/> Welded <input type="checkbox"/> Class 12 in. RMP <input checked="" type="checkbox"/> PVC Weight 160 lbs./ft. Dia. 5 in. to 135 ft. depth Wall Thickness inches or Dia. in. to ft. depth gage No. 025		
			10. Screen: Manufacturer's name Certain-teed Type PVC Dia. 5 in Slot/gauze 1/16 Length 10 Set between 125 ft. and 135 ft. ft. and 1/4 ft. Gravel pack? <input checked="" type="checkbox"/> Size range of material		
			11. Static water level: 80 ft. below land surface Date 2-20-76 mo./day/yr.		
12. Pumping level below land surfaces: ft. after hrs. pumping g.p.m. ft. after hrs. pumping g.p.m. Estimated maximum yield g.p.m.			13. Water sample submitted: mo./day/yr. Yes <input checked="" type="checkbox"/> No <input type="checkbox"/> Date		
14. Well head completion: <input checked="" type="checkbox"/> Pitless adapter _____ Inches above grade			15. Well grouted? <input checked="" type="checkbox"/> With: Neat cement _____ Bentonite <input checked="" type="checkbox"/> Concrete Depth: From 4 ft. to 14 ft.		
16. Closest source of possible contamination: ft. 60 Direction NE Type Sewer Line Well disinfected upon completion? <input checked="" type="checkbox"/> Yes <input type="checkbox"/> No			17. Pump: <input checked="" type="checkbox"/> Not installed Manufacturer's name _____ Model number _____ HP _____ Volts _____ Length of drop pipe _____ ft. capacity _____ g.p.m. Type: <input type="checkbox"/> Submersible <input type="checkbox"/> Turbine <input type="checkbox"/> Jet <input type="checkbox"/> Reciprocating <input type="checkbox"/> Centrifugal <input type="checkbox"/> Other		
18. Elevation: Topography: <input type="checkbox"/> Hill <input type="checkbox"/> Slope <input checked="" type="checkbox"/> Upland <input type="checkbox"/> Valley	19. Remarks: Owner to run concrete slab around well		20. Water well contractor's certification: This well was drilled under my jurisdiction and this report is true to the best of my knowledge and belief. Backhus Drilling 180 Business name License No. Address Tampa, Kansas 67183 Signed Paul Backhus Date 2-20-76 Authorized representative		

Forward the white, blue and pink copies to the Department of Health and Environment

Form WWC-5