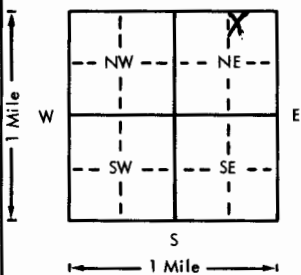


USE TYPEWRITER OR BALL
POINT PEN-PRESS FINELY,
PRINT CLEARLY.

WATER WELL RECORD
KSA 82a-1201-1215

Kansas Department of Health and
Environment-Division of Environment
(Water well Contractors)
Topeka, Kansas 66620

1. Location of well: County <u>McPherson</u> Fraction <u>N 1/4 NE 1/4 NE 1/4</u> Section number <u>30</u> Township number <u>T 19 S</u> Range number <u>R 3 E</u>	
2. Distance and direction from nearest town or city: <u>4 W 81-56 Junction</u> 3. Owner of well: <u>John Edgar</u> Street address of well location if in city: <u>McPherson</u> R.R. or street: <u>BR 2</u> City, state, zip code: <u>McPherson KS 67460</u>	
4. Locate with "X" in section below: Sketch map: 	
5. Type and color of material	
Top Soil @ 3	
yellow clay 3 45	
fine sand 45 52	
Red clay 52 68	
Medium Sand 68 94	
Medium Co Course Sand 94 125	
18. Elevation: Topography: <input type="checkbox"/> Hill <input type="checkbox"/> Slope <input checked="" type="checkbox"/> Upland <input type="checkbox"/> Valley	
19. Remarks:	

Forward the white, blue and pink copies to the Department of Health and Environment

Form WWC-5