


1 LOCATION OF WATER WELL: Fraction NE 1/4 NE 1/4 NW 1/4 Section Number 30 Township Number T 19 S Range Number R 3 E
 County: McPherson

Distance and direction from nearest town or city street address of well if located within city?

1/2 West of McPherson

2 WATER WELL OWNER: Vern Taylor
 RR#, St. Address, Box #: 1719 West 1st
 City, State, ZIP Code: McPherson KS 67460
 Board of Agriculture, Division of Water Resources
 Application Number:

3 LOCATE WELL'S LOCATION WITH AN "X" IN SECTION BOX: 4 DEPTH OF COMPLETED WELL: 130 ft. ELEVATION: 85 ft.

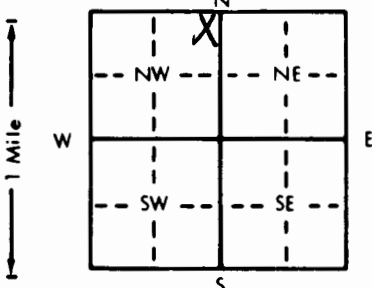

Depth(s) Groundwater Encountered 1. 85 ft. 2. 100 ft. 3. 130 ft.
 WELL'S STATIC WATER LEVEL 85 ft. below land surface measured on mo/day/yr 6-28-93

Pump test data: Well water was 100 ft. after 4 hours pumping 20 gpm

Est. Yield 20 gpm: Well water was 100 ft. after 4 hours pumping 20 gpm

Bore Hole Diameter 10 in. to 130 ft. and 130 in. to 130 ft.

WELL WATER TO BE USED AS: 5 Public water supply 8 Air conditioning 11 Injection well

1 Domestic 3 Feedlot 6 Oil field water supply 9 Dewatering 12 Other (Specify below)

2 Irrigation 4 Industrial 7 Lawn and garden only 10 Monitoring well

Was a chemical/bacteriological sample submitted to Department? Yes No; If yes, mo/day/yr sample was submitted

Water Well Disinfected? Yes Yes No

5 TYPE OF BLANK CASING USED: 5 Wrought iron 8 Concrete tile CASING JOINTS Glued Clamped

1 Steel 3 RMP (SR) 6 Asbestos-Cement 9 Other (specify below) Welded

2 PVC 4 ABS 7 Fiberglass Threaded

Blank casing diameter 5 in. to 110 ft. Dia 110 in. to 110 ft. Dia 110 in. to 110 ft.

Casing height above land surface 14 in. weight 160 lbs./ft. Wall thickness or gauge No. 160

TYPE OF SCREEN OR PERFORATION MATERIAL: 10 Asbestos-cement

1 Steel 3 Stainless steel 5 Fiberglass 8 RMP (SR) 11 Other (specify)

2 Brass 4 Galvanized steel 6 Concrete tile 9 ABS 12 None used (open hole)

SCREEN OR PERFORATION OPENINGS ARE: 5 Gauzed wrapped 8 Saw cut 11 None (open hole)

1 Continuous slot 3 Mill slot 6 Wire wrapped 9 Drilled holes

2 Louvered shutter 4 Key punched 7 Torch cut 10 Other (specify)

SCREEN-PERFORATED INTERVALS: From 110 ft. to 130 ft. From 110 ft. to 130 ft.


GRAVEL PACK INTERVALS: From 100 ft. to 130 ft. From 100 ft. to 130 ft.


6 GROUT MATERIAL: 1 Neat cement 2 Cement grout 3 Bentonite 4 Other

Grout intervals: From 95 ft. to 100 ft. From 0 ft. to 20 ft. From 0 ft. to 20 ft.

What is the nearest source of possible contamination: 10 Livestock pens 14 Abandoned water well

1 Septic tank 4 Lateral lines 7 Pit privy 11 Fuel storage 15 Oil well/Gas well

2 Sewer lines 5 Cess pool 8 Sewage lagoon 12 Fertilizer storage 16 Other (specify below)

3 Watertight sewer lines 6 Seepage pit 9 Feedyard 13 Insecticide storage

Direction from well? SE How many feet? 100

FROM TO LITHOLOGIC LOG FROM TO PLUGGING INTERVALS

0 6 Top Soil

6 50 Clay

50 75 Sand (M) & Clay

75 130 Gravel (Medium)

7 CONTRACTOR'S OR LANDOWNER'S CERTIFICATION: This water well was 1 constructed, (2) reconstructed, or (3) plugged under my jurisdiction and was completed on (mo/day/year) 6-28-93 and this record is true to the best of my knowledge and belief. Kansas

Water Well Contractor's License No. 2480 This Water Well Record was completed on (mo/day/yr) 1-25-94

under the business name of Carl Vincent by (signature) Carl Vincent