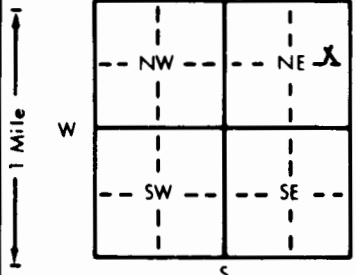


1 LOCATION OF WATER WELL: County: McPHERSON	Fraction SE 1/4 NE 1/4 NE 1/4	Section Number 31	Township Number T 19 S	Range Number R 3 E
---	---	-----------------------------	----------------------------------	------------------------------

Distance and direction from nearest town or city street address of well if located within city?

McPHERSON AIRPORT

2 WATER WELL OWNER: RR#, St. Address, Box # : City, State, ZIP Code	McPHERSON ATT: MELVIN FERGUSON 400 E. KS. AVE. - PO BOX 1008 - McPHERSON KS 67460	Board of Agriculture, Division of Water Resources Application Number:
---	--	--

3 LOCATE WELL'S LOCATION WITH AN "X" IN SECTION BOX: 	4 DEPTH OF COMPLETED WELL: ft. ELEVATION: ft. Depth(s) Groundwater Encountered 1. 82 ft. 2. ft. 3. ft. WELL'S STATIC WATER LEVEL ft. below land surface measured on mo/day/yr Pump test data: Well water was NA ft. after hours pumping gpm Est. Yield gpm: Well water was ft. after hours pumping gpm Bore Hole Diameter 7.25 in. to ft. and in. to ft. WELL WATER TO BE USED AS: 5 Public water supply 8 Air conditioning 11 Injection well 1 Domestic 3 Feedlot 6 Oil field water supply 9 Dewatering 12 Other (Specify below) 2 Irrigation 4 Industrial 7 Lawn and garden only 10 <u>Monitoring well</u> Was a chemical/bacteriological sample submitted to Department? Yes No X If yes, mo/day/yr sample was submitted Water Well Disinfected? Yes No X
--	--

5 TYPE OF BLANK CASING USED: 1 Steel 3 RMP (SR) 5 Wrought iron 8 Concrete tile 2 <u>PVC</u> 4 <u>ABS</u> 6 Asbestos-Cement 9 Other (specify below) Blank casing diameter in. to ft. Dia in. to ft. Dia in. to ft. Casing height above land surface 24 in., weight SCH 40 lbs./ft. Wall thickness or gauge No.	CASING JOINTS: Glued Clamped Welded Threaded X
TYPE OF SCREEN OR PERFORATION MATERIAL: 1 Steel 3 Stainless steel 5 Fiberglass 8 RMP (SR) 2 Brass 4 Galvanized steel 6 Concrete tile 9 ABS SCREEN OR PERFORATION OPENINGS ARE: 1 Continuous slot 3 <u>3 Mill slot</u> 5 Gauzed wrapped 8 Saw cut 11 None (open hole) 2 Louvered shutter 4 Key punched 7 Torch cut 10 Other (specify) SCREEN-PERFORATED INTERVALS: From 73.5 ft. to 98.5 ft. From ft. to ft. From ft. to ft. From ft. to ft. SAND GRAVEL PACK INTERVALS: From 72.5 ft. to 100 ft. From ft. to ft. From ft. to ft. From ft. to ft.	10 Asbestos-cement 11 Other (specify) 12 None used (open hole)

6 GROUT MATERIAL: 1 Neat cement 2 <u>Cement grout</u> 3 Bentonite 4 Other Grout Intervals: From 64 ft. to 72.5 ft. From 72.5 ft. to 74.5 ft. From ft. to ft. What is the nearest source of possible contamination: 1 Septic tank 4 Lateral lines 7 Pit privy 10 Livestock pens 14 Abandoned water well 2 Sewer lines 5 Cess pool 8 Sewage lagoon 11 Fuel storage 15 Oil well/Gas well 3 Watertight sewer lines 6 Seepage pit 9 Feedyard 12 Fertilizer storage 16 Other (specify below) 13 Insecticide storage Direction from well? ON SITE - SOME REMOVED How many feet?
--

FROM	TO	LITHOLOGIC LOG	FROM	TO	PLUGGING INTERVALS
64	1.5	TOP SOIL			
1.5	22	CLAY			
22	30	SILTY CLAY			
30	46	SILTY SAND			
46		SAND			

7 CONTRACTOR'S OR LANDOWNER'S CERTIFICATION: This water well was (1) constructed, (2) reconstructed, or (3) plugged under my jurisdiction and was completed on (mo/day/year) 09-27-93 and this record is true to the best of my knowledge and belief. Kansas Water Well Contractor's License No. 479 This Water Well Record was completed on (mo/day/yr) 10-24-93 under the business name of EBBERTS DRILLING by (signature) <i>Greg Ebberts</i>
--