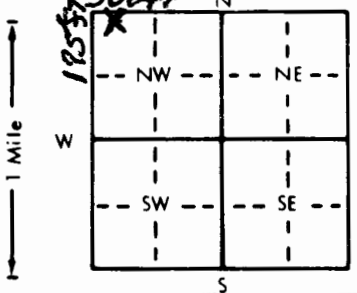


1 LOCATION OF WATER WELL: County: <u>McPherson</u>		Fraction <u>NW 1/4 NW 1/4 NW 1/4</u>		Section Number <u>32</u>	Township Number <u>T 19 S</u>	Range Number <u>R 3</u>	<u>W</u>
Distance and direction from nearest town or city street address of well if located within city? <u>801 South Highway 81 Bypass McPherson KS</u>							
2 WATER WELL OWNER: <u>Westridge Apartments</u>		Board of Agriculture, Division of Water Resources Application Number: <u>50077 WERTH</u>					
RR#, St. Address, Box #: <u>801 South Highway 81 Bypass</u>							
City, State, ZIP Code: <u>McPherson, Kansas 67460</u>							
3 LOCATE WELL'S LOCATION WITH AN "X" IN SECTION BOX: 		4 DEPTH OF COMPLETED WELL: <u>UNKNOWN</u> ft. ELEVATION: <u>UNKNOWN</u> ft.					
		Depth(s) Groundwater Encountered 1. <u>UNKNOWN</u> ft. 2. <u>UNKNOWN</u> ft. 3. <u>UNKNOWN</u> ft.					
		WELL'S STATIC WATER LEVEL <u>UNKNOWN</u> ft. below land surface measured on mo/day/yr <u>3-1-91</u>					
		Pump test data: Well water was <u>UNKNOWN</u> ft. after <u>UNKNOWN</u> hours pumping <u>UNKNOWN</u> gpm					
		Est. Yield <u>UNKNOWN</u> gpm: Well water was <u>UNKNOWN</u> ft. after <u>UNKNOWN</u> hours pumping <u>UNKNOWN</u> gpm					
		Bore Hole Diameter <u>W25</u> in. to <u>UNKNOWN</u> ft., and <u>UNKNOWN</u> in. to <u>UNKNOWN</u> ft.					
		WELL WATER <u>W25</u> USED AS: 5 Public water supply 8 Air conditioning 11 Injection well 1 Domestic 3 Feedlot 6 Oil field water supply 9 Dewatering 12 Other (Specify below) 2 Irrigation 4 Industrial 7 Lawn and garden only 10 Monitoring well					
		Was a chemical/bacteriological sample submitted to Department? Yes <u>NO</u> No <u>NO</u> ; If yes, mo/day/yr sample was submitted <u>NO</u>					
5 TYPE OF BLANK CASING USED:		5 Wrought iron		8 Concrete tile		CASING JOINTS: Glued <u>NO</u> Clamped <u>NO</u>	
1 Steel		3 RMP (SR)		6 Asbestos-Cement		9 Other (specify below) <u>Welded</u>	
2 PVC		4 ABS		7 Fiberglass		Threaded <u>NO</u>	
Blank casing diameter <u>6"</u> in. to <u>72'0"</u> ft., Dia <u>6"</u> in. to <u>72'0"</u> ft., Dia <u>6"</u> in. to <u>72'0"</u> ft.							
Casing height above land surface <u>1 ft below</u> weight <u>117 lbs/ft</u> lbs./ft. Wall thickness or gauge No. <u>11</u>							
TYPE OF SCREEN OR PERFORATION MATERIAL:		5 Fiberglass		8 RMP (SR)		11 Other (specify) <u>14 Abandoned water well</u>	
1 Steel		3 Stainless steel		9 ABS		12 None used (open hole)	
2 Brass		4 Galvanized steel		10 Asbestos-cement			
SCREEN OR PERFORATION OPENINGS ARE:		5 Gauzed wrapped		8 Saw cut		11 None (open hole)	
1 Continuous slot		6 Wire wrapped		9 Drilled holes			
2 Louvered shutter		7 Torch cut		10 Other (specify)			
3 Mill slot							
4 Key punched							
SCREEN-PERFORATED INTERVALS: From <u>72'0"</u> ft. to <u>1'0"</u> ft., From <u>72'0"</u> ft. to <u>1'0"</u> ft., From <u>72'0"</u> ft. to <u>1'0"</u> ft.							
GRAVEL PACK INTERVALS: From <u>72'0"</u> ft. to <u>1'0"</u> ft., From <u>72'0"</u> ft. to <u>1'0"</u> ft., From <u>72'0"</u> ft. to <u>1'0"</u> ft.							
6 GROUT MATERIAL: 1 Neat cement		2 Cement grout		3 Bentonite		4 Other <u>14 Abandoned water well</u>	
Grout Intervals: From <u>72'0"</u> ft. to <u>1'0"</u> ft., From <u>72'0"</u> ft. to <u>1'0"</u> ft., From <u>72'0"</u> ft. to <u>1'0"</u> ft.							
What is the nearest source of possible contamination:		7 Pit privy		10 Livestock pens		14 Abandoned water well	
1 Septic tank		8 Sewage lagoon		11 Fuel storage		15 Oil well/Gas well	
2 Sewer lines		9 Feedyard		12 Fertilizer storage		16 Other (specify below)	
3 Watertight sewer lines				13 Insecticide storage			
4 Lateral lines							
5 Cess pool							
6 Seepage pit							
Direction from well?				How many feet?			
FROM	TO	LITHOLOGIC LOG	FROM	TO	PLUGGING INTERVALS		
<u>72'0"</u>	<u>1'0"</u>	<u>Cement (Cement Grout)</u>					
<u>0'8"</u>	<u>0'6"</u>	<u>CLAYS</u>					
<u>0'4"</u>	<u>0'0"</u>	<u>SAND</u>					
		<u>4 inch of CEMENT FLOOR ON TOP. INSIDE OF BUILDING</u>					
		<u>Plugged</u>					
		<u>North Apartment Building</u>	<u>3/4 yard of concrete</u>				
		<u>Casing set in cement to start with.</u>					
		<u>Plugged</u>					
7 CONTRACTOR'S OR LANDOWNER'S CERTIFICATION: This water well was (1) constructed, (2) reconstructed, or (3) plugged under my jurisdiction and was completed on (mo/day/year) <u>3-4-91</u> and this record is true to the best of my knowledge and belief. Kansas Water Well Contractor's License No. <u>3-7-91</u> This Water Well Record was completed on (mo/day/yr) <u>3-7-91</u> under the business name of <u>Frank D. Hallgrath</u> by (signature) <u>Frank D. Hallgrath</u>							