WATER WELL RECORD Form WWC-5 KSA 82a-1212

1 LOCATION OF WATER WELL: County: McPherson | Fraction: NE ¼ NW ¼ SE ¼ | Section Number: 34 | Township Number: T 19 S | Range Number: R 3 E W

Distance and direction from nearest town or city street address of well if located within city?
1 mile SE of McPherson, KS

2 WATER WELL OWNER: Gary Feldman & John Decina, Environmental Transport
RR#, St. Address, Box # : 3001 Yorktown Blvd/3A
City, State, ZIP Code : Toms River, NJ 08753
Board of Agriculture, Division of Water Resources
Application Number:

3 LOCATE WELL'S LOCATION WITH AN "X" IN SECTION BOX:

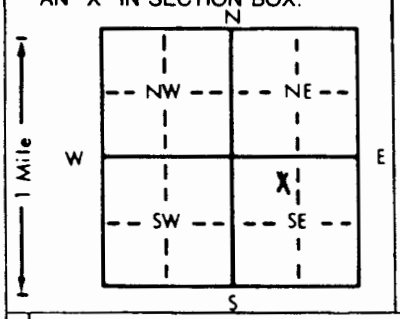

4 DEPTH OF COMPLETED WELL 42 ft. ELEVATION: 1411.74
Depth(s) Groundwater Encountered 1 ..... ft. 2 ..... ft. 3 ..... ft.
WELL'S STATIC WATER LEVEL 999/NONE ft. below land surface measured on mo/day/yr 10-14-91
Pump test data: Well water was ..... ft. after ..... hours pumping ..... gpm
Est. Yield ..... gpm: Well water was ..... ft. after ..... hours pumping ..... gpm
Bore Hole Diameter 8 in. to Hollow stem ft., and ..... in. to ..... ft.
WELL WATER TO BE USED AS: 5 Public water supply 8 Air conditioning 11 Injection well
1 Domestic 3 Feedlot 6 Oil field water supply 9 Dewatering (12) Other (Specify below)
2 Irrigation 4 Industrial 7 Lawn and garden only 10 Monitoring well Boring/Grab sample
Was a chemical/bacteriological sample submitted to Department? Yes X No ; If yes, mo/day/yr sample was submitted 10-14-91 Water Well Disinfected? Yes (No)

5 TYPE OF BLANK CASING USED: 1 Steel 2 PVC N/A 3 RMP (SR) 4 ABS 5 Wrought iron 6 Asbestos-Cement 7 Fiberglass 8 Concrete tile 9 Other (specify below)
CASING JOINTS: Glued ..... Clamped ..... Welded ..... Threaded .....
Blank casing diameter NONE in. to ..... ft., Dia ..... in. to ..... ft., Dia ..... in. to ..... ft.
Casing height above land surface NONE in., weight ..... lbs./ft. Wall thickness or gauge No. .....
TYPE OF SCREEN OR PERFORATION MATERIAL: 1 Steel 2 Brass N/A 3 Stainless steel 4 Galvanized steel 5 Fiberglass 6 Concrete tile 7 PVC 8 RMP (SR) 9 ABS 10 Asbestos-cement 11 Other (specify) 12 None used (open hole)
SCREEN OR PERFORATION OPENINGS ARE: 1 Continuous slot 2 Louvered shutter N/A 3 Mill slot 4 Key punched 5 Gauzed wrapped 6 Wire wrapped 7 Torch cut 8 Saw cut 9 Drilled holes 10 Other (specify) 11 None (open hole)
SCREEN-PERFORATED INTERVALS: From ..... ft. to ..... ft., From ..... ft. to ..... ft.
From ..... ft. to ..... ft., From ..... ft. to ..... ft.
GRAVEL PACK INTERVALS: From ..... ft. to ..... ft., From ..... ft. to ..... ft.
From ..... ft. to ..... ft., From ..... ft. to ..... ft.

6 GROUT MATERIAL: 55 1 Neat cement 20 2 Cement grout 3 Bentonite 4 Other Cement & Bentonite grout mix
Grout Intervals: From 1453.75 ft. to 1418.75 ft., From ..... ft. to ..... ft., From ..... ft. to ..... ft.
What is the nearest source of possible contamination:
1 Septic tank 2 Sewer lines 3 Watertight sewer lines 4 Lateral lines 5 Cess pool 6 Seepage pit 7 Pit privy 8 Sewage lagoon 9 Feedyard 10 Livestock pens 11 Fuel storage 12 Fertilizer storage 13 Insecticide storage 14 Abandoned water well 15 Oil well/Gas well (16) Other (specify below) Landfill site
Direction from well? Boring installed within the landfill How many feet?

FROM	TO	LITHOLOGIC LOG	FROM	TO	PLUGGING INTERVALS
		SEE ATTACHED SHEET			

7 CONTRACTOR'S OR LANDOWNER'S CERTIFICATION: This water well was (1) constructed, (2) reconstructed, or (3) plugged under my jurisdiction and was completed on (mo/day/year) October 14, 1991 and this record is true to the best of my knowledge and belief. Kansas Water Well Contractor's License No. KDHE This Water Well Record was completed on (mo/day/yr) October 18, 1991 under the business name of KDHE by (signature)

INSTRUCTIONS: Use typewriter or ball point pen. *PLEASE PRESS FIRMLY* and *PRINT* clearly. Please fill in blanks, underline or circle the correct answers. Send top three copies to Kansas Department of Health and Environment, Bureau of Water, Topeka, Kansas 66620-0001. Telephone: 913-296-5545. Send one to WATER WELL OWNER and retain one for your records.

FROM	TO	LITHOLOGIC LOG	FROM	TO	PLUGGING INTERVALS
1476 ~ Surface Elev	1473	Lean Clay with Sand Red-Brown			
1473	1469	Lean Clay and Calcareous Red Brown and White			
1469 ±	1453	Lean Clay trace sand Red Brown			
Boring Start Elevation					
1453	1446	Lean Clay with medium Sand Red Brown	1453.74		
1446	1443	Lean Clay (silty) Light Red Brown			
1443	1437	Lean Clay trace Calcareous nodules Light Red Brown	trace sand		
1437	1435	Lean Clay (silty) Light Red Brown			
1435	1428	Lean Clay with Fine Sand Light Brown			
1428	1426	Silty Clayey Sand Light Red Brown			
1426	1421	Silty Sand (medium grained) Red Brown			
1421	1412	Sand (medium) trace silt & clay Red Brown			
		H_2O (static) = 1418.74		1418.74	
1412	1411	Shale (Highly weathered) Greyish Green			
BOB	1411				