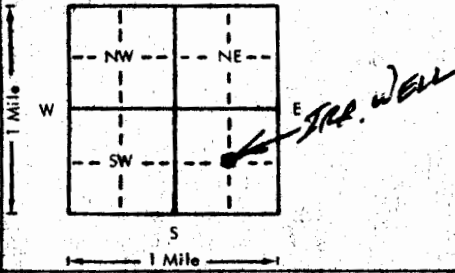


USE TYPEWRITER OR BALL
POINT PEN-PRESS FIRMLY,
PRINT CLEARLY.

WATER WELL RECORD
KSA 82a-1201-1215

Kansas Department of Health and
Environment-Division of Environment
(Water well Contractors)
Topeka, Kansas 66620

Location of well:		County MCPHERSON	Fraction Center of 1/4 1/4 SE 1/4	Section number 8	Township number T 19 S	Range number R 3 W
2. Distance and direction from nearest town or city: 5 mi. SO OF MCPHERSON, KANS			3. Owner of well: MARDIN NEUFELDT. R.R. or street: City, state, zip code: BOLHLE, KANS 67522			
4. Locate with "X" in section below:		Sketch map:		6. Bore hole dia. 30 in. Completion date 5-5-77 Well depth 205 ft.		
				7. Cable tool ☐ Rotary ☐ Driven ☐ Dug ☐ Hollow rod ☐ Jetted ☐ Bored ☒ Reverse rotary		
5. Type and color of material		From	To	8. Use: Domestic ☐ Public supply ☐ Industry ☒ Irrigation ☒ Air conditioning ☐ Stock ☐ Lawn ☐ Oil field water ☐ Other ☐		
Top soil		0	5	9. Casing: Material Transite Sight: Above or below Threaded ☐ Welded ☐ Surface ☒ 12 in. RMP ☐ PVC ☐ Weight 32 lbs./ft. Dia. 16 in. to 20 ft. depth Wall Thickness: inches or Dia. ☐ in. to ☐ ft. depth gage No. 3/4 "		
Clay - Brown		5	33	10. Screen: Manufacturer's name AURORA TILE CO. Type TRANSITE Dia. 16" I.P. Slot/gauze 1/8" Length 65 ft Set between 136 ft. and 201 ft. ft. and ☐ ft.		
Clay - Buff		33	56	Gravel pack? ☒ Size range of material 1/4"		
SAND - FINE + CLAY MIXTURE		56	68	11. Static water level: ☐ mo./day/yr. 54 ft. below land surface Date 5-10-77		
SAND - FINE		68	75	12. Pumping level below land surfaces: ft. after ☐ hrs. pumping ☐ g.p.m. ft. after ☐ hrs. pumping ☐ g.p.m. Estimated maximum yield 1500 g.p.m.		
SAND - MED.		75	78	13. Water sample submitted: ☐ mo./day/yr. Yes ☒ No ☐ Date ☐		
Clay - Grey		78	81	14. Well head completion: Pitless adapter ☒ 12 inches above grade		
SAND - MED. TO FINE (GREY)		81	95	15. Well grouted? ☒ Full depth clay With: ☐ Neat cement ☐ Bentonite ☐ Concrete Depth: From 0 ft. to 15 ft.		
Clay - Sandy		95	101	16. Nearest source of possible contamination: ft. 1400 Direction NE Type Well Well disinfected upon completion? Yes ☒ No ☐		
SAND - w/SMALL LAYER OF CLAY		101	120	17. Pump: Not installed Manufacturer's name LAKE BOWLER Model number ☐ HP 50 Volts 6.4 Length of drop pipe 70 ft. capacity 800 g.p.m. Type: ☐ Submersible ☒ Turbine ☐ Jet ☐ Reciprocating ☐ Centrifugal ☐ Other		
SAND - MEDIUM COARSE		120	136	20. Water well contractor's certification: This well was drilled under my jurisdiction and this report is true to the best of my knowledge and belief. PETERSON INC. INC 138 Business name Box 150 License No. Address Waller, Kansas Signed Wally Peterson Date 5-24-78 Authorized representative		
Clay - Green		136	140			
SAND - MED TO COARSE		140	151			
Limestone		151	152			
Clay - Brown		152	157			
SAND - MED TO COARSE		157	199			
18. Elevation:		19. Remarks: SHALE - GREY		199-201		
Topography: ☐ Hill ☐ Slope ☐ Upland ☐ Valley						