WATER WELL PLUGGING RECORD Form WWC-5P KSA 82a-1212 ID NO.

1 LOCATION OF WATER WELL: County: McPherson | Fraction: SW ¼ NW ¼ SE ¼ ¼ | Section Number: 28 | Township Number: T 19 S | Range Number: 3 ☐ E ☑ W

Street/Rural Address of Well Location; if unknown, distance & direction from nearest town or intersection: If at owner's address, check here ☑ 314 Hynes Street McPherson, KS 67460

Global Positioning Systems (GPS) information:
Latitude: 38.366139 (in decimal degrees)
Longitude: 97.656278 (in decimal degrees)
Elevation: 1482
Datum: ☐ WGS84, ☑ NAD83, ☐ NAD27
Collection Method:
☑ GPS unit (Make/Model: Garmin/Legend Extrex
☐ Digital Map/Photo, ☐ Topographic Map, ☐ Land Survey
Est. Accuracy: ☐ < 3 m, ☑ 3-5 m, ☐ 5-15 m, ☐ > 15 m

2 WATER WELL OWNER: Fred Bohnenblust
RR#, St. Address, Box #: 314 Hynes Street
City, State ZIP Code: McPherson, KS 67460

3 MARK WELL'S LOCATION WITH AN "X" IN SECTION BOX:

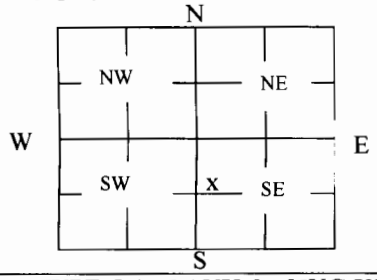

4 DEPTH OF WELL 60 ft.
WELL'S STATIC WATER LEVEL Dry ft
WELL WAS USED AS:
☑ Domestic ☐ Irrigation ☐ Feedlot ☐ Industrial
☐ Public Water Supply ☐ Oil Field Water Supply ☐ Domestic (Lawn & Garden) ☐ Air Conditioning
☐ Dewatering ☐ Monitoring ☐ Injection Well ☐ Other
Was a chemical/bacteriological sample submitted to Department? Yes ☐ No ☑

5 TYPE OF ~~BLANK~~ CASING USED: Casing was cutoff 36 inches below land surface.
☐ Steel ☐ PVC ☐ RMP (SR) ☐ ABS ☐ Wrought ☐ Asbestos-Cement ☐ Fiberglass ☐ Concrete Tile ☑ Other (Specify below) 16 gauge galvanized steel
~~Blank casing diameter~~ in. Was casing pulled? Yes ☑ No ☐ If yes, how much 36 inches
Casing height above or below land surface 36 in.

6 GROUT PLUG MATERIAL: ☐ Neat cement ☑ Cement grout ☑ Bentonite ☐ Other

Grout Plug Intervals: From 60 ft. to 50 ft., From 50 ft. to 3.5 ft., From 3.5 to 0 ft.

What is the nearest source of possible contamination:
☐ Septic tank ☑ Sewer lines ☐ Watertight sewer lines ☐ Lateral lines ☐ Cess pool
☐ Seepage pit ☐ Pit privy ☐ Sewage lagoon ☐ Feedyard ☐ Livestock pens
☐ Fuel Storage ☐ Fertilizer storage ☐ Insecticide storage ☐ Abandoned water well ☐ Oil well/Gas well
☐ Other (specify below)
Direction from well? North
How many feet? 50-75

FROM	TO	PLUGGING MATERIALS	FROM	TO	PLUGGING MATERIALS
60	50	Bentonite			
50	3.5	Cement			
3.5	3.0	Bentonite			
3.0	2.5	Cement Cap			
2.5	0	Topsoil			

7 CONTRACTOR'S OR LANDOWNER'S CERTIFICATION: This water well was plugged under my jurisdiction and was completed on (mo/day/year) 09/14/2011 and this record is true to the best of my knowledge and belief. Kansas Water Well Contractor's License No. N/A. This Water Well Record was completed on (mo/day/year) 09/14/2011 under the business name of McPherson Board of Public Utilities by (signature) [signature]

INSTRUCTIONS: Use typewriter or ballpoint pen. Please press firmly and print clearly. Please fill in blanks, underline or circle the correct answers. Send top three copies to Kansas Department of Health and Environment, Bureau of Water, Geology Section, 1000 SW Jackson St., Ste. 420, Topeka, Kansas 66612-1367. Telephone: 785/296-5524. Send one to Water Well Owner and retain one for your records. Visit us at http://www.kdheks.gov/waterwell/index.html.

Check one: ☑ White Copy ☐ Blue Copy ☐ Pink Copy