

County: McPherson Fraction NW NW NW SE Sec. 22 T 19 S R 3 E (W)

CORRECTION(S) TO WATER WELL COMPLETION RECORD (WWC-5)
(to rectify lacking or incorrect information)

Owner: Precision Industries

Location was listed as:

Section-Township-Range: 22-10S-3W

Fraction (1/4 1/4 1/4): NW NW NW SE

Location changed to:

22-19S-3W

NW NW NW SE

Other changes: Initial statements: _____

Changed to: _____

Comments: _____

Verification method: Latitude & longitude, KGS' "LEO" conversion tool, written description, city street map, and mapping tool & aerial photos on KGS website. initials: DRL date: 5/2/2016

Submitted by: Kansas Geological Survey, Data Resources Library, 1930 Constant Ave., Lawrence, KS 66047-3726
to: Kansas Dept of Health & Environment, Bureau of Water, 1000 SW Jackson, Suite 420, Topeka, KS 66612-1367.


WATER WELL PLUGGING RECORD Form WWC-5P KSA 82a-1212 ID NO.

1 LOCATION OF WATER WELL: Fraction NW 1/4 NW 1/4 NW 1/4 SE 1/4 Section Number 22 Township Number T 10 S Range Number 3 E W
 County: McPherson

Street/Rural Address of Well Location; if unknown, distance & direction from nearest town or intersection: If at owner's address, check here 1/4N of 533 N. Baer Str. 1/2 m in field

Global Positioning Systems (GPS) information:
 Latitude: 38.38385 (in decimal degrees)
 Longitude: 097.63878 (in decimal degrees)
 Elevation: 1478
 Datum: WGS84, NAD83, NAD27
 Collection Method:
 GPS unit (Make/Model: Garman 62S)
 Digital Map/Photo, Topographic Map, Land Survey
 Est. Accuracy: < 3 m, 3-5 m, 5-15 m, > 15 m

2 WATER WELL OWNER: Precision Industries
 RR#, St. Address, Box #: 533 N. Baer Str.
 City, State ZIP Code: McPherson, Kansas 67460

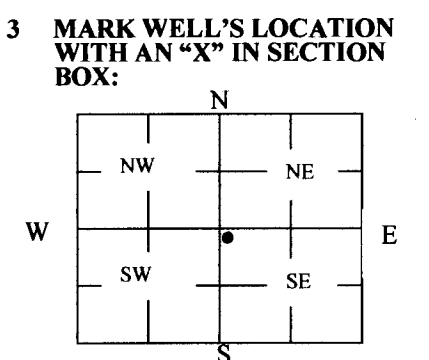

4 DEPTH OF WELL 108 **ft.**
 WELL'S STATIC WATER LEVEL 74 **ft**
 WELL WAS USED AS:
 Domestic Public Water Supply Dewatering
 Irrigation Oil Field Water Supply Monitoring
 Feedlot Domestic (Lawn & Garden) Injection Well
 Industrial Air Conditioning Other Pond
 Was a chemical/bacteriological sample submitted to Department? Yes No

5 TYPE OF BLANK CASING USED:
 Steel RMP (SR) Wrought Fiberglass Other (Specify below)
 PVC ABS Asbestos-Cement Concrete Tile
 Blank casing diameter _____ in. Was casing pulled? Yes No If yes, how much _____
 Casing height above or below land surface 48 in.

6 GROUT PLUG MATERIAL: Neat cement Cement grout Bentonite Other _____
 Grout Plug Intervals: From 108 ft. to 60 ft., From 60 ft. to 20 ft., From 20 to 0 ft.

What is the nearest source of possible contamination:
 Septic tank Seepage pit Fuel Storage Other (specify below)
 Sewer lines Pit privy Fertilizer storage New well
 Watertight sewer lines Sewage lagoon Insecticide storage
 Lateral lines Feedyard Abandoned water well Direction from well? West
 Cess pool Livestock pens Oil well/Gas well How many feet? 60'

FROM	TO	PLUGGING MATERIALS	FROM	TO	PLUGGING MATERIALS
0	20	Hole plug			
20	60	sand			
60	108	gravel			

7 CONTRACTOR'S OR LANDOWNER'S CERTIFICATION: This water well was plugged under my jurisdiction and was completed on (mo/day/year) 7/27/2015 and this record is true to the best of my knowledge and belief. Kansas Water Well Contractor's License No. 134. This Water Well Record was completed on (mo/day/year) 8/4/2015 under the business name of Rosencrantz-Bemis Ent. by (signature) [Signature]

INSTRUCTIONS: Use typewriter or ballpoint pen. Please press firmly and print clearly. Please fill in blanks, underline or circle the correct answers. Send top three copies to Kansas Department of Health and Environment, Bureau of Water, Geology Section, 1000 SW Jackson St., Ste. 420, Topeka, Kansas 66612-1367. Telephone: 785/296-5524. Send one to Water Well Owner and retain one for your records. Visit us at <http://www.kdheks.gov/waterwell/index.html>.

Check one: White Copy Blue Copy Pink Copy