

County: McPherson Fraction NW NW NW SE Sec. 22 T 19 S R 3 E/W

CORRECTION(S) TO WATER WELL COMPLETION RECORD (WWC-5)

(to rectify lacking or incorrect information)

Owner: Precision Industries

Location was listed as:

Location changed to:

Section-Township-Range: 22-105-3W

22-195-3W

Fraction (1/4 1/4 1/4): NW NW NW SE

NW NW NW SE

Other changes: Initial statements: _____

Changed to: _____

Comments: _____

Verification method: Latitude & longitude, KGS' "LEO" conversion tool, written description, city street map, and mapping tool & aerial photos on KGS website. initials: DR date: 5/2/2016

Submitted by: Kansas Geological Survey, Data Resources Library, 1930 Constant Ave., Lawrence, KS 66047-3726
to: Kansas Dept of Health & Environment, Bureau of Water, 1000 SW Jackson, Suite 420, Topeka, KS 66612-1367.

WATER WELL RECORD


Form WWC-5

Division of Water Resources App. No.

1 LOCATION OF WATER WELL: County: McPherson Fraction NW 1/4 NW 1/4 NW 1/4 SE 1/4 Section Number 22 Township No. T 10 S Range Number R 3 [] E [x] W

Street/Rural Address of Well Location; if unknown, distance & direction from nearest town or intersection: If at owner's address, check here []. 1/4N of 533 N. Baer Str. behind Sequoya Trans. in field Global Positioning System (GPS) information: Latitude: 38.38384 Longitude: 097.63859 Elevation: 1515 Datum: [] WGS 84, [] NAD 83, [x] NAD 27 Collection Method: [x] GPS unit (Make/Model: Garmin 62S) [] Digital Map/Photo, [x] Topographic Map, [] Land Survey Est. Accuracy: [] <3 m, [x] 3-5 m, [] 5-15 m, [] >15 m

2 WATER WELL OWNER: Precision Industries RR#, Street Address, Box #: 533 N. Baer Str. City, State, ZIP Code : McPherson. Kansas 67460

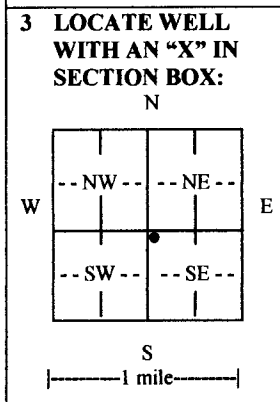

3 LOCATE WELL WITH AN 'X' IN SECTION BOX: 4 DEPTH OF COMPLETED WELL 106 ft. Depth(s) Groundwater Encountered (1)..... ft. (2)..... ft. (3)..... ft. WELL'S STATIC WATER LEVEL 73 ft. below land surface measured on mo/day/yr. 7/27/2015 Pump test data: Well water was.....ft. after..... hours pumping..... gpm EST. YIELD.....gpm. Well water was.....ft. after..... hours pumping..... gpm Bore Hole Diameter 10.....in. to 106.....ft., and.....in. to.....ft. WELL WATER TO BE USED AS: [] Public water supply [] Geothermal [] Injection well [] Domestic [] Feedlot [] Oil field water supply [] Dewatering [x] Other (Specify below) [] Irrigation [] Industrial [] Domestic-lawn & garden [] Monitoring well Pond Was a chemical/bacteriological sample submitted to Department? [] Yes [x] No If yes, mo/day/yr sample was submitted..... Water well disinfected? [x] Yes [] No

5 TYPE OF CASING USED: [] Steel [] PVC [] Other CASING JOINTS: [x] Glued [] Clamped [x] Welded [] Threaded Casing diameter .5..... in. to .86..... ft., Diameter..... in. to..... ft., Diameter..... in. to..... ft. Casing height above land surface...14..... in., Weight .160.....lbs./ft., Wall thickness or gauge No. ...214

TYPE OF SCREEN OR PERFORATION MATERIAL: [] Steel [] Stainless Steel [x] PVC [] Other (Specify) [] Brass [] Galvanized Steel [] None used (open hole) SCREEN OR PERFORATION OPENINGS ARE: [] Continuous slot [] Mill slot [] Gauze wrapped [] Torch cut [] Drilled holes [] None (open hole) [] Louvered shutter [] Key punched [] Wire wrapped [x] Saw cut [] Other (specify) SCREEN-PERFORATED INTERVALS: From .86..... ft. to 106..... ft., From..... ft. to..... ft. GRAVEL PACK INTERVALS: From 106..... ft. to 20..... ft., From..... ft. to..... ft. From..... ft. to..... ft., From..... ft. to..... ft.

6 GROUT MATERIAL: [] Neat cement [] Cement grout [x] Bentonite [] Other Grout Intervals: From 20..... ft. to 0..... ft., From..... ft. to..... ft., From..... ft. to..... ft. What is the nearest source of possible contamination: [] Septic tank [] Lateral lines [] Pit privy [] Livestock pens [] Insecticide storage [] Other (specify below) [] Sewer lines [] Cesspool [] Sewage lagoon [] Fuel storage [x] Abandoned water well [] Watertight sewer lines [] Seepage pit [] Feedyard [] Fertilizer storage [] Oil well/gas well Direction from well East Distance from well .60'

Table with columns: FROM, TO, LITHOLOGIC LOG, FROM, TO, LITHO. LOG (cont.) or PLUGGING INTERVALS. Rows include soil types like Top soil, Brown clay, Tan clay, Tan clay-sandy, Tan clay, Tan clay w/caliche strks., Tan clay-fine sand mix 70/30, Fine sand w/pcs. of tan clay, Tan clay - sandy, Tan clay-tight and sticky.

7 CONTRACTOR'S OR LANDOWNER'S CERTIFICATION: This water well was [x] constructed, [] reconstructed, or [] plugged under my jurisdiction and was completed on (mo/day/year) 7/27/2015 and this record is true to the best of my knowledge and belief. Kansas Water Well Contractor's License No. 134 This Water Well Record was completed on (mo/day/year) 8/4/2015 under the business name of Rosencrantz-Bemis Ent. by (signature) [Signature]

INSTRUCTIONS: Use typewriter or ball point pen. PLEASE PRESS FIRMLY and PRINT clearly. Please fill in blanks and check the correct answers. Send three copies (white, blue, pink) to Kansas Department of Health and Environment, Bureau of Water, Geology Section, 1000 SW Jackson St., Suite 420, Topeka, Kansas 66612-1367. Telephone 785-296-5524. Send one copy to WATER WELL OWNER and retain one for your records. Include fee of \$5.00 for each constructed well. Visit us at http://www.kdheks.gov/waterwell/index.html.