

WATER WELL RECORD

Form WWC-5

Division of Water Resources App. No.


Well ID

MW13

Original Record Correction Change in Well Use

1 LOCATION OF WATER WELL: County McPherson Fraction SW 1/4 SE 1/4 NE 1/4 SE 1/4 Section Number 29 Township Number T 19 S Range Number R 3 E W

2 WELL OWNER: Last Name: Business: Mac Pizz, LLC Address: 1903 Lewis Ave City: Salina State: KS ZIP: 67401 Street or Rural Address where well is located (if unknown, distance and direction from nearest town or intersection): NW corner of Skancke and Maple St, McPherson, KS

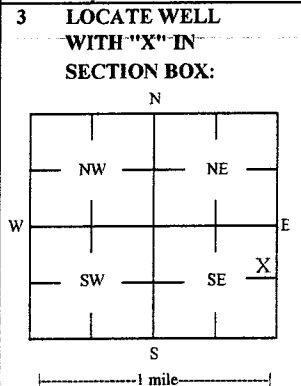

3 LOCATE WELL WITH 'X' IN SECTION BOX: 4 DEPTH OF COMPLETED WELL: 104.5 ft Depth(s) Groundwater Encountered: 1) 104.5 ft 2) ft 3) ft or 4) Dry Well WELL'S STATIC WATER LEVEL: 95.25 ft

5 Latitude: 38.36631 (decimal degrees) Longitude: 97.66839 (decimal degrees) Horizontal Datum: X WGS 84 NAD 83 NAD 27 Source for Latitude/Longitude: X GPS (unit make/model): Land Survey Topographic Map Online Mapper 6 Elevation 1497.96 ft Ground Level X TOC Source: X Land Survey GPS Topographic Map Other

7 WELL WATER TO BE USED AS: 1 Domestic: Household Lawn & Garden Livestock Irrigation Feedlot Industrial 2 Public Water Supply: well ID 3 Dewatering: how many wells? 4 Aquifer Recharge: well ID 5 Monitoring: well ID MW13 6 Environmental Remediation: well ID Air Sparge Soil Vapor Extraction Recovery Injection 7 Oil Field Water Supply: lease 8 Test Hole: well ID Cased Uncased Geotechnical 9 Geothermal: How many bores? a) Closed Loop Horizontal Vertical b) Open Loop Surface Discharge Inj. of Water Other (specify):

Was a chemical/bacteriological sample submitted to KDHE? Yes No X No If yes, date sample was submitted: Water well disinfected? Yes No X No

8 TYPE OF CASING USED: Steel PVC Other CASING JOINTS: Glued Clamped Welded X Threaded Casing diameter 2 in. to 74.5 ft, Diameter in. to ft, Diameter in. to ft, Casing height above land surface -0.32 in. Weight lbs./ft. Well thickness or gauge No TYPE OF SCREEN OR PERFORATION MATERIAL: Steel Stainless Steel Fiberglass PVC Other (Specify) Brass Galvanized Steel Concrete tile None used (open hole) SCREEN OR PERFORATION OPENINGS ARE: Continuous Slot X Mill Slot Gauze Wrapped Torch Cut Drilled Holes Other (Specify) Louvered Shutter Key Punched Wire Wrapped Saw Cut None (Open Hole) SCREEN-PERFORATED INTERVALS: From 74.5 ft. to 104.5 ft, From ft. to ft, From ft. to ft, GRAVEL PACK INTERVALS: From 72 ft. to 107 ft, From ft. to ft, From ft. to ft,

9 GROUT MATERIAL: Neat cement Cement grout X Bentonite X Other Concrete: 0-1' Grout intervals: From 1 ft. to 68 ft, From 68 ft. to 72 ft, From ft. to ft,

Nearest source of possible contamination: Septic Tank Lateral Lines Pit Privy Livestock Pens Insecticide Storage Sewer Lines Cess Pool Sewage Lagoon X Fuel Storage Abandoned Water Well Watertight Sewer Lines Seepage Pit Feedyard Fertilizer Storage Oil Well / Gas Well Other (Specify) Direction from well? E-NE Distance from well? ~445 ft

Table with columns: FROM, TO, LITHOLOGIC LOG, FROM, TO, LITHO. LOG (cont.) or PLUGGING INTERVALS. Rows: 0-65 Topsoil: silty clay, 65-85 Silty clay and sand, 85-98 Sand, 98-107 Silty clay. Notes: KDHE ID: Little Caesars; U5-059-14487

11 CONTRACTOR'S OR LANDOWNER'S CERTIFICATION: This water well was X constructed, reconstructed or plugged under my jurisdiction and was completed on (mo-day-year) 12/9/15 and this record is true to the best of my knowledge and belief. Kansas Water Well Contractor's License No 757 This Water Well Record was completed on (mo-day-year) 2/4/16 under the business name of Larsen & Associates, Inc. Signature