

WATER WELL RECORD

Form WWC-5

Division of Water Resources App. No.


Well ID

MW11

Original Record Correction Change in Well Use

1 LOCATION OF WATER WELL: County McPherson Fraction NE 1/4 NE 1/4 SE 1/4 SE 1/4 Section Number 29 Township Number T 19 S Range Number R 3 E W

2 WELL OWNER: Last Name: Business: Mac Pizz, LLC Address: 1903 Lewis Ave City Salina State KS ZIP: 67401 Street or Rural Address where well is located (if unknown, distance and direction from nearest town or intersection): 414 S. Main St., McPherson, KS

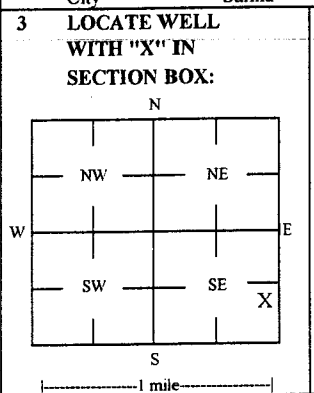

3 LOCATE WELL WITH 'X' IN SECTION BOX: 4 DEPTH OF COMPLETED WELL: 103.1 ft Depth(s) Groundwater Encountered: 1) 103.1 ft 2) ft 3) ft or 4) Dry Well WELL'S STATIC WATER LEVEL: 93.35 ft

5 Latitude: 38.36563 (decimal degrees) Longitude: 97.66718 (decimal degrees) Horizontal Datum: X WGS 84 Ground Level: X TOC Source: X Land Survey

7 WELL WATER TO BE USED AS: 1 Domestic: Household, Lawn & Garden, Livestock, Irrigation, Feedlot, Industrial 2 Public Water Supply: well ID 3 Dewatering: how many wells? 4 Aquifer Recharge: well ID 5 Monitoring: well ID MW11 6 Environmental Remediation: well ID 7 Air Sparge 8 Soil Vapor Extraction 9 Recovery 10 Injection 11 Oil Field Water Supply: lease 12 Test Hole: well ID 13 Cased 14 Uncased 15 Geotechnical 16 Geothermal: How many bores? 17 a) Closed Loop 18 Horizontal 19 Vertical 20 b) Open Loop 21 Surface Discharge 22 Inj. of Water 23 Other (specify):

Was a chemical/bacteriological sample submitted to KDHE? Yes No X No If yes, date sample was submitted: Water well disinfected? Yes No X No

8 TYPE OF CASING USED: Steel PVC Other CASING JOINTS: Glued Clamped Welded X Threaded Casing diameter 2 in. to 73.1 ft Diameter in. to ft Diameter in. to ft Casing height above land surface -0.5 in. Weight lbs./ft. Well thickness or gauge No TYPE OF SCREEN OR PERFORATION MATERIAL: Steel Stainless Steel Fiberglass PVC Other (Specify) Brass Galvanized Steel Concrete tile None used (open hole) SCREEN OR PERFORATION OPENINGS ARE: Continuous Slot X Mill Slot Gauze Wrapped Torch Cut Drilled Holes Other (Specify) Louvered Shutter Key Punched Wire Wrapped Saw Cut None (Open Hole) SCREEN-PERFORATED INTERVALS: From 73.1 ft. to 103.1 ft. From ft. to ft. From ft. to ft. GRAVEL PACK INTERVALS: From 71 ft. to 107 ft. From ft. to ft. From ft. to ft.

9 GROUT MATERIAL: Neat cement Cement grout X Bentonite X Other Concrete: 0-1' Grout intervals: From 1 ft. to 67 ft. From 67 ft. to 71 ft. From ft. to ft.

Nearest source of possible contamination: Septic Tank Lateral Lines Pit Privy Livestock Pens Insecticide Storage Sewer Lines Cess Pool Sewage Lagoon X Fuel Storage Abandoned Water Well Watertight Sewer Lines Seepage Pit Feedyard Fertilizer Storage Oil Well / Gas Well Other (Specify) Direction from well? NE Distance from well? ~312 ft

Table with columns: FROM, TO, LITHOLOGIC LOG, FROM, TO, LITHO. LOG (cont.) or PLUGGING INTERVALS. Rows: 0-60 Topsoil: Silty clay; 60-84 Silty clay with sand; 84-98 Sand; 98-107 Silty clay

Notes: KDHE ID: Little Caesars; U5-059-14487

11 CONTRACTOR'S OR LANDOWNER'S CERTIFICATION: This water well was constructed, reconstructed, or plugged under my jurisdiction and was completed on (mo-day-year) 12/1/15 and this record is true to the best of my knowledge and belief. Kansas Water Well Contractor's License No 757 This Water Well Record was completed on (mo-day-year) 2/4/16 under the business name of Larsen & Associates, Inc. Signature

Mail 1 white copy along with a fee of \$5.00 for each constructed well to: Kansas Department of Health and Environment, Bureau of Water, GWTS Section, 1000 SW Jackson St., Suite 420, Topeka, Kansas 66612-1367. Mail one to Water Well Owner and retain one for your records. Telephone 785-296-5524.