

WATER WELL RECORD Form WWC-5


Division of Water Resources App. No.

Well ID SB-02

Original Record Correction Change in Well Use

1 LOCATION OF WATER WELL: County: Mpherson Fraction: NW 1/4 NW 1/4 NE 1/4 SW 1/4 Section Number: 20 Township Number: T 19 S Range Number: R 3 E W

2 WELL OWNER: Last Name: Aero Transportation First: Street or Rural Address where well is located (if unknown, distance and direction from nearest town or intersection): If at owner's address, check here:
 Business Address: 1330 OLD U.S. 81
 City: Mpherson State: KS ZIP: 67460

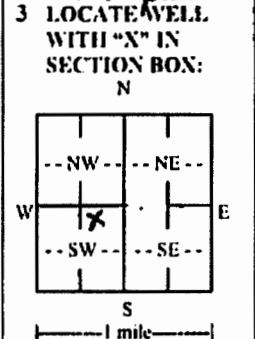

4 DEPTH OF COMPLETED Boreing 120' ft. Depth(s) Groundwater Encountered: 1) 38' ft. 2) ft. 3) ft. or 4) Dry Well
WELL'S STATIC WATER LEVEL: ft.
 below land surface, measured on (mo-day-yr) ft.
 above land surface, measured on (mo-day-yr) ft.
 Pump test data: Well water was ft. after hours pumping gpm
 Well water was ft. after hours pumping gpm
 Estimated Yield: gpm
 Bore Hole Diameter: in. to ft. and in. to ft.

5 Latitude: 38.383665 (decimal degrees)
Longitude: -97.678829 (decimal degrees)
Horizontal Datum: WGS 84 NAD 83 NAD 27
Source for Latitude/Longitude: Smart Phone
 GPS (unit make/model:) (WAAS enabled? Yes No)
 Land Survey Topographic Map
 Online Mapper:

6 Elevation: ft. Ground Level TOC
Source: Land Survey GPS Topographic Map Other

7 WELL WATER TO BE USED AS:

1. Domestic: <input type="checkbox"/> Household <input type="checkbox"/> Lawn & Garden <input type="checkbox"/> Livestock	5. <input type="checkbox"/> Public Water Supply: well ID <u> </u>	10. <input type="checkbox"/> Oil Field Water Supply: lease <u> </u>
2. <input type="checkbox"/> Irrigation	6. <input type="checkbox"/> Dewatering: how many wells? <u> </u>	11. Test Hole: well ID <u> </u> <input type="checkbox"/> Cased <input type="checkbox"/> Uncased <input type="checkbox"/> Geotechnical
3. <input type="checkbox"/> Feedlot	7. <input type="checkbox"/> Aquifer Recharge: well ID <u> </u>	12. Geothermal: how many bores? <u> </u> a) Closed Loop <input type="checkbox"/> Horizontal <input type="checkbox"/> Vertical b) Open Loop <input type="checkbox"/> Surface Discharge <input type="checkbox"/> Inj. of Water
4. <input type="checkbox"/> Industrial	8. <input type="checkbox"/> Monitoring: well ID <u> </u>	13. <input checked="" type="checkbox"/> Other (specify): <u>Boreing</u>
	9. Environmental Remediation: well ID <u> </u> <input type="checkbox"/> Air Sparge <input type="checkbox"/> Soil Vapor Extraction <input type="checkbox"/> Recovery <input type="checkbox"/> Injection	

Was a chemical/bacteriological sample submitted to KDHE? Yes No If yes, date sample was submitted:
Water well disinfected? Yes No

8 TYPE OF CASING USED: Steel PVC Other CASING JOINTS: Glued Clamped Welded Threaded
 Casing diameter in. to ft., Diameter in. to ft., Diameter in. to ft.
 Casing height above land surface in. Weight lbs./ft. Wall thickness or gauge No.

TYPE OF SCREEN OR PERFORATION MATERIAL: Steel Stainless Steel Fiberglass PVC Other (Specify)
 Brass Galvanized Steel Concrete tile None used (open hole)

SCREEN OR PERFORATION OPENINGS ARE: Continuous Slot Mill Slot Gauze Wrapped Torch Cut Drilled Holes Other (Specify)
 Louvered Shutter Key Punched Wire Wrapped Saw Cut None (Open Hole)

SCREEN-PERFORATED INTERVALS: From ft. to ft., From ft. to ft., From ft. to ft., From ft. to ft.
GRAVEL PACK INTERVALS: From ft. to ft., From ft. to ft., From ft. to ft.

9 GROUT MATERIAL: Neat cement Cement grout Bentonite Other Best Grout - Large Gravel
 Grout Intervals: From 0 ft. to 120 ft., From ft. to ft., From ft. to ft., From ft. to ft.

Nearest source of possible contamination:
 Septic Tank Lateral Lines Pit Privy Livestock Pens Insecticide Storage
 Sewer Lines Cess Pool Sewage Lagoon Fuel Storage Abandoned Water Well
 Watertight Sewer Lines Seepage Pit Feedyard Fertilizer Storage Oil Well/Gas Well
 Other (Specify)
 Direction from well? Distance from well? ft.

10 FROM	TO	LITHOLOGIC LOG	FROM	TO	LITHO. LOG (cont.) or PLUGGING INTERVALS
0	1'	Topsoil			
1	64'	Clay - S.H.			
64'	120'	F-M Sand			

Notes:

11 CONTRACTOR'S OR LANDOWNER'S CERTIFICATION: This Boreing was constructed, reconstructed, or plugged under my jurisdiction and was completed on (mo-day-year) 08-02-2016 and this record is true to the best of my knowledge and belief. Kansas Water Well Contractor's License No. 297 This Water Well Record was completed on (mo-day-year) 08-02-2016 under the business name of Cascade Drilling Signature Randy Ruel