

WATER WELL RECORD

Form WWC-5

Division of Water Resources App. No.


Well ID

MW16

Original Record Correction Change in Well Use

1 LOCATION OF WATER WELL: County McPherson Fraction NE 1/4 NE 1/4 SE 1/4 SE 1/4 Section Number 29 Township Number T 19 S Range Number R 3 E

2 WELL OWNER: Last Name: Business: Mac Pizza, LLC Address: 1903 Lewis Ave City: Salina State: KS ZIP: 67401 Street or Rural Address where well is located (if unknown, distance and direction from nearest town or intersection): 502 S. Main St., McPherson, KS

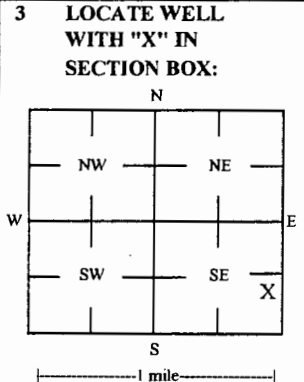

3 LOCATE WELL WITH 'X' IN SECTION BOX: 4 DEPTH OF COMPLETED WELL: 101 ft Depth(s) Groundwater Encountered: 1) 101 ft 2) 87.7 ft 3) 87.7 ft or 4) Dry Well WELL'S STATIC WATER LEVEL: 87.7 ft

5 Latitude: 38.36504 (decimal degrees) Longitude: 97.66706 (decimal degrees) Horizontal Datum: X WGS 84 GPS (unit make/model): Land Survey

6 Elevation 1492.18 ft Ground Level TOC Source: X Land Survey GPS

7 WELL WATER TO BE USED AS: 1 Domestic: Household, Lawn & Garden, Livestock, Irrigation, Feedlot, Industrial 2 Public Water Supply: well ID 3 Dewatering: how many wells? 4 Aquifer Recharge: well ID 5 Monitoring: well ID MW16 6 Environmental Remediation: well ID 7 Air Sparge, Soil Vapor Extraction, Recovery, Injection 8 Oil Field Water Supply: lease 9 Test Hole: well ID 10 Cased, Uncased, Geotechnical 11 Geothermal: How many bores? 12 a) Closed Loop, Horizontal, Vertical b) Open Loop, Surface Discharge, Inj. of Water, Other

Was a chemical/bacteriological sample submitted to KDHE? Yes No X No If yes, date sample was submitted: Water well disinfected? Yes No X No

8 TYPE OF CASING USED: Steel PVC Other CASING JOINTS: Glued Clamped Welded Threaded Casing diameter 2 in. to 71 ft, Diameter in. to ft, Diameter in. to ft, Casing height above land surface -0.23 in. Weight lbs./ft. Well thickness or gauge No TYPE OF SCREEN OR PERFORATION MATERIAL: Steel Stainless Steel Fiberglass PVC Other (Specify) SCREEN OR PERFORATION OPENINGS ARE: Continuous Slot Mill Slot Gauze Wrapped Torch Cut Drilled Holes Other (Specify) Louvered Shutter Key Punched Wire Wrapped Saw Cut None (Open Hole) SCREEN-PERFORATED INTERVALS: From 71 ft. to 101 ft. GRAVEL PACK INTERVALS: From 67 ft. to 101 ft.

9 GROUT MATERIAL: Neat cement Cement grout Bentonite Other Concrete: 0-0.5' Grout intervals: From 0.5 ft. to 67 ft. From ft. to ft. From ft. to ft.

Nearest source of possible contamination: Septic Tank Lateral Lines Pit Privy Livestock Pens Insecticide Storage Sewer Lines Cess Pool Sewage Lagoon Fuel Storage Abandoned Water Well Watertight Sewer Lines Seepage Pit Feedyard Fertilizer Storage Oil Well / Gas Well Other (Specify)

Direction from well? NNE Distance from well? ~500 ft

Table with columns: 10 FROM, TO, LITHOLOGIC LOG, FROM, TO, LITHO. LOG (cont.) or PLUGGING INTERVALS. Rows: 0-26 Topsoil: silty clay, 26-65 Clayey silt, 65-75 Clayey silt w/ sand, 75-90 Quartzose sand, 90-105.5 Silty clay

Notes: KDHE ID: Little Caesars; U5-059-14487. Several feet were lost due to borehole collapse prior to well installation.

11 CONTRACTOR'S OR LANDOWNER'S CERTIFICATION: This water well was constructed, reconstructed, or plugged under my jurisdiction and was completed on (mo-day-year) 2/21-22/17 and this record is true to the best of my knowledge and belief. Kansas Water Well Contractor's License No 757 This Water Well Record was completed on (mo-day-year) 3/16/17 under the business name of Larsen & Associates, Inc. Signature

TRITERRA

LAND SERVICES

P.O. Box 546
Clearwater, Kansas 67026
Cell (316) 648-3617 Fax (620) 584-4371
E-mail: triterrals@yahoo.com

SURVEYING OF ADDITIONAL MONITORING WELLS (2-28-17)
LITTLE CAESARS
McPHERSON, KANSAS

The above site is in Section 28, Township 19 South, Range 3 West of the Sixth Principal Meridian, McPherson County, Kansas. The Southeast corner of Section 28 was assigned coordinates of 00.00 North and 00.00 West.

The previously established control point was used for vertical control and is described as a chiseled 'X' on the concrete on the west side of the Little Caesars sign.

The Latitude and Longitude were recorded from a GPS unit. The site is located on the 7.5' quad map titled "McPherson South".

ID	NORTH	WEST	LATITUDE	LONGITUDE	ELEVATION
SE CORNER 28-19S-3W	00.00	00.00			
Control Point	1593.64	5233.18	38.36653	97.66676	1495.05
MW-15(Sec 29) NW NE SE SE	1210.91	5654.85	38.36549	97.66830	RIM 1496.03 TOC 1495.78
MW-16(Sec 29) NE NE SE SE	1057.01	5329.89	38.36504	97.66706	RIM 1492.41 TOC 1492.18
MW-17(Sec 29) SW NE SE SE	886.80	5856.61	38.36458	97.66891	RIM 1497.57 TOC 1497.20



RECEIVED
APR 12 2017
BUREAU OF WATER