

WATER WELL RECORD

Form WWC-5

Division of Water Resources App. No.


Well ID

MW15

Original Record Correction Change in Well Ust

1 LOCATION OF WATER WELL: County McPherson Fraction NW 1/4 NE 1/4 SE 1/4 SE 1/4 Section Number 29 Township Number T 19 S Range Number R 3 E W

2 WELL OWNER: Last Name: First: Street or Rural Address where well is located (if unknown, distance and direction from nearest town or intersection): 423 S. Maple St., McPherson, KS

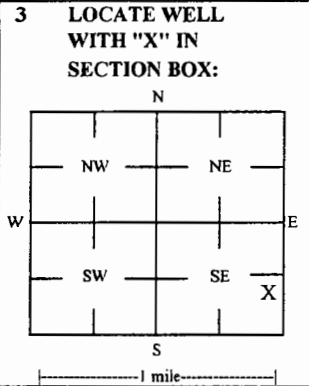

4 DEPTH OF COMPLETED WELL: 102 ft Depth(s) Groundwater Encountered: 1) 102 ft 2) ft 3) ft, or 4) Dry Well WELL'S STATIC WATER LEVEL: 91.47 ft

5 Latitude: 38.36549 (decimal degrees) Longitude: 97.66830 (decimal degrees) Horizontal Datum: X WGS 84 NAD 83 NAD 27

6 Elevation 1495.78 ft Ground Level X TOC Source: X Land Survey GPS Topographic Map Other

7 WELL WATER TO BE USED AS: 1 Domestic: Household, Lawn & Garden, Livestock, Irrigation, Feedlot, Industrial

Was a chemical/bacteriological sample submitted to KDHE? Yes No Water well disinfected? Yes No

8 TYPE OF CASING USED: Steel PVC Other CASING JOINTS: Glued Clamped Welded Threaded Casing diameter 2 in. to 72 ft

9 GROUT MATERIAL: Neat cement Cement grout Bentonite Other Concrete: 0-0.5' Grout intervals: From 0.5 ft. to 69 ft

Nearest source of possible contamination: Septic Tank Lateral Lines Pit Privy Livestock Pens Insecticide Storage

Direction from well? NE Distance from well? ~500 ft

Table with columns: FROM, TO, LITHOLOGIC LOG, FROM, TO, LITHO. LOG (cont.) or PLUGGING INTERVALS

Notes: KDHE ID: Little Caesars; U5-059-14487. Several feet were lost due to borehole collapse prior to well installation.

11 CONTRACTOR'S OR LANDOWNER'S CERTIFICATION: This water well was constructed, reconstructed, or plugged under my jurisdiction and was completed on (mo-day-year) 2/23/17

TRITERRA

LAND SERVICES

P.O. Box 546
Clearwater, Kansas 67026
Cell (316) 648-3617 Fax (620) 584-4371
E-mail: triterrals@yahoo.com

SURVEYING OF ADDITIONAL MONITORING WELLS (2-28-17)
LITTLE CAESARS
McPHERSON, KANSAS

The above site is in Section 28, Township 19 South, Range 3 West of the Sixth Principal Meridian, McPherson County, Kansas. The Southeast corner of Section 28 was assigned coordinates of 00.00 North and 00.00 West.

The previously established control point was used for vertical control and is described as a chiseled 'X' on the concrete on the west side of the Little Caesars sign.

The Latitude and Longitude were recorded from a GPS unit. The site is located on the 7.5' quad map titled "McPherson South".

ID	NORTH	WEST	LATITUDE	LONGITUDE	ELEVATION
SE CORNER 28-19S-3W	00.00	00.00			
Control Point	1593.64	5233.18	38.36653	97.66676	1495.05
MW-15(Sec 29) NW NE SE SE	1210.91	5654.85	38.36549	97.66830	RIM 1496.03 TOC 1495.78
MW-16(Sec 29) NE NE SE SE	1057.01	5329.89	38.36504	97.66706	RIM 1492.41 TOC 1492.18
MW-17(Sec 29) SW NE SE SE	886.80	5856.61	38.36458	97.66891	RIM 1497.57 TOC 1497.20



RECEIVED
APR 12 2017
BUREAU OF WATER