

WATER WELL RECORD Form WWC-5

Original Record Correction Change in Well Use


Division of Water Resources App. No.

Well ID

MW-7S

1 LOCATION OF WATER WELL: County: McPherson Fraction SW 1/4 SE 1/4 SE 1/4 SW 1/4 Section Number 29 Township Number T 19 S Range Number R 3 E W

2 WELL OWNER: Last Name: KOHE Business: GSI Engineering Address: 4600 E 47th St South City: Wichita State: KS ZIP: 67210 Street or Rural Address where well is located: 171ft south of intersection of S Lucy St & W Hayes St

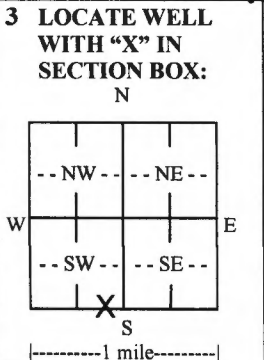

3 LOCATE WELL WITH 'X' IN SECTION BOX: 4 DEPTH OF COMPLETED WELL: 105 ft. Depth(s) Groundwater Encountered: 1) 60 ft. 2) 60 ft. 3) 60 ft. 4) Dry Well WELL'S STATIC WATER LEVEL: 60 ft. below land surface, measured on (mo-day-yr) 05/01/2020

5 Latitude: 38.36254 Longitude: 97.67800 Datum: WGS 84 GPS (unit make/model):

6 Elevation: 1481 ft. Ground Level TOC Source: Land Survey GPS Topographic Map Other KOLAR

7 WELL WATER TO BE USED AS: 1. Domestic: Household, Lawn & Garden, Livestock, Irrigation, Feedlot, Industrial. 2. Public Water Supply, Dewatering, Aquifer Recharge, Monitoring, Environmental Remediation, Air Sparge, Soil Vapor Extraction, Recovery, Injection, Oil Field Water Supply, Test Hole, Geothermal, Closed Loop, Open Loop, Surface Discharge, Inj. of Water, Other (specify).

Was a chemical/bacteriological sample submitted to KDHE? Yes No If yes, date sample was submitted: Water well disinfected? Yes No

8 TYPE OF CASING USED: Steel PVC Other CASING JOINTS: Glued Clamped Welded Threaded Casing diameter 4 in. to 105 ft., Diameter in. to ft., Diameter in. to ft. Casing height above land surface 0 in. Weight lbs./ft. Wall thickness or gauge No. SCH-40

TYPE OF SCREEN OR PERFORATION MATERIAL: Steel Stainless Steel PVC Other (Specify) Brass Galvanized Steel None used (open hole)

SCREEN OR PERFORATION OPENINGS ARE: Continuous Slot Mill Slot Gauze Wrapped Torch Cut Drilled Holes Other (Specify) Louvered Shutter Key Punched Wire Wrapped Saw Cut None (Open Hole)

SCREEN-PERFORATED INTERVALS: From 85 ft. to 105 ft., From ft. to ft., From ft. to ft. GRAVEL PACK INTERVALS: From 83 ft. to 105 ft., From ft. to ft., From ft. to ft.

9 GROUT MATERIAL: Neat cement Cement grout Bentonite Other Grout intervals: From 0 ft. to 83 ft., From ft. to ft., From ft. to ft.

Nearest source of possible contamination: No potential source of contamination within 200 ft. Septic Tank Lateral Lines Pit Privy Livestock Pens Insecticide Storage Sewer Lines Cess Pool Sewage Lagoon Fuel Storage Abandoned Water Well Watertight Sewer Lines Seepage Pit Feedyard Fertilizer Storage Oil Well/Gas Well Other (Specify)

Table with columns: 10 FROM, TO, LITHOLOGIC LOG, FROM, TO, LITHO. LOG (cont.) or PLUGGING INTERVALS. Rows: 0-3 Soil, 3-21 Clay, 21-35 Sandy Clay, 35-60 Fine sand, 60-81 Medium Sand, 81-107 Fine Sand Clay

Notes:

11 CONTRACTOR'S OR LANDOWNER'S CERTIFICATION: This water well was constructed, reconstructed, or plugged under my jurisdiction and was completed on (mo-day-year) 05/01/2020 and this record is true to the best of my knowledge and belief. Kansas Water Well Contractor's License No. 914 This Water Well Record was completed on (mo-day-year) 05/08/2020 under the business name of Flint Hills Drilling #914