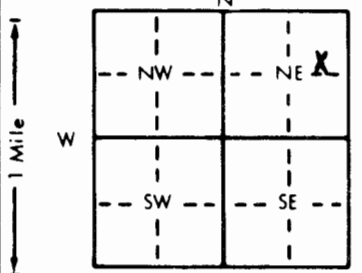


1 LOCATION OF WATER WELL:	Fraction	Section Number	Township Number	Range Number
County: <u>McPherson</u>	<u>SE 1/4 NE 1/4 NE 1/4</u>	<u>29</u>	T <u>19</u> S	R <u>3</u> EW

Distance and direction from nearest town or city street address of well if located within city?

519 N. Main, McPherson

2 WATER WELL OWNER: <u>USD 481</u> <u>ATHN: W.N. Ppart</u>	Board of Agriculture, Division of Water Resources
RR#, St. Address, Box #: <u>514 N. Main</u>	Application Number: <u>—</u>
City, State, ZIP Code: <u>McPherson, KS 67460</u>	

3 LOCATE WELL'S LOCATION WITH AN "X" IN SECTION BOX:	4 DEPTH OF COMPLETED WELL: <u>97.0</u> ft. ELEVATION: <u>—</u>
	Depth(s) Groundwater Encountered: <u>1. 84.0</u> ft. 2. <u>—</u> ft. 3. <u>—</u> ft.
	WELL'S STATIC WATER LEVEL: <u>85.03</u> ft. below land surface measured on <u>mo/day/yr 1-22-95</u>
	Pump test data: Well water was <u>—</u> ft. after <u>—</u> hours pumping <u>—</u> gpm
	Est. Yield <u>—</u> gpm: Well water was <u>—</u> ft. after <u>—</u> hours pumping <u>—</u> gpm
	Bore Hole Diameter: <u>8.625</u> in. to <u>97</u> ft. and <u>—</u> in. to <u>—</u> ft.
	WELL WATER TO BE USED AS:
	5 Public water supply 8 Air conditioning 11 Injection well
	1 Domestic 3 Feedlot 6 Oil field water supply 9 Dewatering 12 Other (Specify below)
	2 Irrigation 4 Industrial 7 Lawn and garden only <u>(10) Monitoring well mw-5</u>
	Was a chemical/bacteriological sample submitted to Department? Yes <u>—</u> No <u>X</u> ; If yes, mo/day/yr sample was submitted <u>—</u>
	Water Well Disinfected? Yes <u>—</u> No <u>X</u>

5 TYPE OF BLANK CASING USED:	5 Wrought iron	8 Concrete tile	CASING JOINTS: Glued <u>—</u> Clamped <u>—</u>
1 Steel	3 RMP (SR)	6 Asbestos-Cement	9 Other (specify below)
<u>(2) PVC</u>	4 ABS	7 Fiberglass	Welded <u>—</u>
Blank casing diameter: <u>2"</u> in. to <u>71.25</u> ft. Dia. <u>—</u> in. to <u>—</u> ft. Dia. <u>—</u> in. to <u>—</u> ft.			Threaded <u>X</u>
Casing height above land surface: <u>0</u> in., weight: <u>Schedule 40</u> lbs./ft. Wall thickness or gauge No. <u>—</u>			
TYPE OF SCREEN OR PERFORATION MATERIAL:	<u>(1) PVC</u>	10 Asbestos-cement	
1 Steel	3 Stainless steel	5 Fiberglass	8 RMP (SR)
2 Brass	4 Galvanized steel	6 Concrete tile	9 ABS
11 Other (specify)			
12 None used (open hole)			
SCREEN OR PERFORATION OPENINGS ARE:	5 Gauzed wrapped	8 Saw cut	11 None (open hole)
1 Continuous slot	<u>(3) Mill slot</u>	6 Wire wrapped	9 Drilled holes
2 Louvered shutter	4 Key punched	7 Torch cut	10 Other (specify)
SCREEN-PERFORATED INTERVALS:	From <u>71.25</u> ft. to <u>96.25</u> ft.	From <u>—</u> ft. to <u>—</u> ft.	From <u>—</u> ft. to <u>—</u> ft.
<u>SAND</u>	From <u>—</u> ft. to <u>—</u> ft.	From <u>—</u> ft. to <u>—</u> ft.	From <u>—</u> ft. to <u>—</u> ft.
<u>GRAVEL</u>	From <u>70.0</u> ft. to <u>97.0</u> ft.	From <u>—</u> ft. to <u>—</u> ft.	From <u>—</u> ft. to <u>—</u> ft.
	From <u>—</u> ft. to <u>—</u> ft.	From <u>—</u> ft. to <u>—</u> ft.	From <u>—</u> ft. to <u>—</u> ft.

6 GROUT MATERIAL: <u>2</u> 1 Neat cement	<u>(2) Cement grout</u>	<u>(3) Bentonite</u>	4 Other <u>—</u>
Grout Intervals: From <u>0</u> ft. to <u>68</u> ft.	From <u>3</u> ft. to <u>68</u> ft.	From <u>70</u> ft. to <u>—</u> ft.	From <u>—</u> ft. to <u>—</u> ft.
What is the nearest source of possible contamination:	10 Livestock pens	14 Abandoned water well	
1 Septic tank	4 Lateral lines	11 Fuel storage	15 Oil well/Gas well
2 Sewer lines	5 Cess pool	12 Fertilizer storage	<u>(16) Other (specify below)</u>
3 Watertight sewer lines	6 Seepage pit	13 Insecticide storage	<u>Contaminated site</u>
9 Feedyard			
Direction from well?	How many feet?		

FROM	TO	LITHOLOGIC LOG	FROM	TO	PLUGGING INTERVALS
<u>0</u>	<u>1.5'</u>	<u>Soil, Silty clay</u>			
<u>1.5</u>	<u>57.0</u>	<u>Silty clay</u>			
<u>57.0</u>	<u>67.0</u>	<u>clayey bit</u>			
<u>67.0</u>	<u>71.0</u>	<u>sandy clay</u>			
<u>71.0</u>	<u>73.0</u>	<u>Sand</u>			
<u>73.0</u>	<u>78.0</u>	<u>Sandy clay</u>			
<u>78.0</u>	<u>80.0</u>	<u>Sand</u>			
<u>80.0</u>	<u>84.0</u>	<u>Silty clay</u>			
<u>84.0</u>	<u>95.0</u>	<u>Sand</u>			
<u>95.0</u>	<u>97.0</u>	<u>shale</u>			
<u>97.0</u>	<u>TD</u>	<u>END OF BOREHOLE</u>			

Flush mount waiver
D. Taylor 11-16-94

7 CONTRACTOR'S OR LANDOWNER'S CERTIFICATION: This water well was <u>(1)</u> constructed, <u>(2)</u> reconstructed, or <u>(3)</u> plugged under my jurisdiction and was completed on (mo/day/year) <u>12-19-94</u> and this record is true to the best of my knowledge and belief. Kansas
Water Well Contractor's License No. <u>585</u> This Water Well Record was completed on (mo/day/yr) <u>12/30/94</u>
under the business name of <u>Associated Environmental, Inc.</u> by (signature) <u>Liam R. [Signature]</u>