


mw-7

1 LOCATION OF WATER WELL: Fraction SE 1/4 NE 1/4 NE 1/4 Section Number 29 Township Number T 19 S Range Number R 3 E W
 County: McPherson
 Distance and direction from nearest town or city street address of well if located within city?

519 N. Main, McPherson, KS

2 WATER WELL OWNER: City of McPherson Board of Agriculture, Division of Water Resources
 RR#, St. Address, Box #: 400 E. Kansas Attn: J. Dossett
 City, State, ZIP Code: McPherson, KS 67460 Application Number:

3 LOCATE WELL'S LOCATION WITH AN "X" IN SECTION BOX: 4 DEPTH OF COMPLETED WELL: 95.0 ft. ELEVATION: —
 Depth(s) Groundwater Encountered 1. 81.9 ft. 2. — ft. 3. — ft.

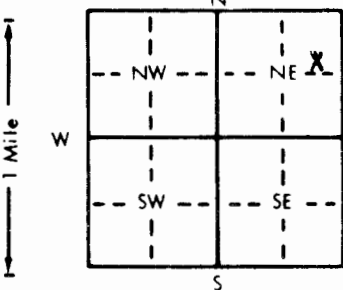

WELL'S STATIC WATER LEVEL 82.65 ft. below land surface measured on mo/day/yr 1-22-95

Pump test data: Well water was — ft. after — hours pumping — gpm

Est. Yield — gpm: Well water was — ft. after — hours pumping — gpm

Bore Hole Diameter 8.625 in. to 95.0 ft. and — in. to — ft.

WELL WATER TO BE USED AS: 5 Public water supply 8 Air conditioning 11 Injection well

1 Domestic 3 Feedlot 6 Oil field water supply 9 Dewatering 12 Other (Specify below)

2 Irrigation 4 Industrial 7 Lawn and garden only (10) Monitoring well mw-7

Was a chemical/bacteriological sample submitted to Department? Yes — No X If yes, mo/day/yr sample was submitted

Water Well Disinfected? Yes — No X

5 TYPE OF BLANK CASING USED: 5 Wrought iron 8 Concrete tile CASING JOINTS: Glued — Clamped —

1 Steel 3 RMP (SR) 6 Asbestos-Cement 9 Other (specify below) Welded —

(2) PVC 4 ABS 7 Fiberglass Threaded X

Blank casing diameter 2" in. to 67.25 ft. Dia — in. to — ft. Dia — in. to — ft.

Casing height above land surface 0 in. weight Schedule 40 lbs./ft. Wall thickness or gauge No. —

TYPE OF SCREEN OR PERFORATION MATERIAL: (1) PVC 10 Asbestos-cement

1 Steel 3 Stainless steel 5 Fiberglass 8 RMP (SR) 11 Other (specify)

2 Brass 4 Galvanized steel 6 Concrete tile 9 ABS 12 None used (open hole)

SCREEN OR PERFORATION OPENINGS ARE: 5 Gauzed wrapped 8 Saw cut 11 None (open hole)

1 Continuous slot (3) Mill slot 6 Wire wrapped 9 Drilled holes

2 Louvered shutter 4 Key punched 7 Torch cut 10 Other (specify) —

SCREEN-PERFORATED INTERVALS: From 67.25 ft. to 92.25 ft. From — ft. to — ft.

From — ft. to — ft. From — ft. to — ft.

From 66.25 ft. to 95.0 ft. From — ft. to — ft.

From — ft. to — ft. From — ft. to — ft.

6 GROUT MATERIAL: 1 Neat cement (2) Cement grout (3) Bentonite 4 Other —

Grout intervals: From 0 ft. to 64.25 ft. From 64.25 ft. to 66.25 ft. From — ft. to — ft.

What is the nearest source of possible contamination: 10 Livestock pens 14 Abandoned water well

1 Septic tank 4 Lateral lines 7 Pit privy 11 Fuel storage 15 Oil well/Gas well

2 Sewer lines 5 Cess pool 8 Sewage lagoon 12 Fertilizer storage (16) Other (specify below)

3 Watertight sewer lines 6 Seepage pit 9 Feedyard 13 Insecticide storage contaminated site

Direction from well? How many feet?

FROM TO LITHOLOGIC LOG FROM TO PLUGGING INTERVALS

0 0.5 Asphalt 0 0.5

0.5 16.5 Silty clay 0.5 16.5

16.5 23.0 clayey silt 16.5 23.0

23.0 66.5 silty clay 23.0 66.5

66.5 77.0 alternating sand and sandy clay 66.5 77.0

77.0 95.0 sand 77.0 95.0

95.0 TD END OF BOREHOLE 95.0 TD

Flush mount waiver

D. Taylor 11-16-94

7 CONTRACTOR'S OR LANDOWNER'S CERTIFICATION: This water well was (1) constructed, (2) reconstructed, or (3) plugged under my jurisdiction and was completed on (mo/day/year) 12-21-94 and this record is true to the best of my knowledge and belief. Kansas

Water Well Contractor's License No. 585 This Water Well Record was completed on (mo/day/yr) 12-30-94

under the business name of Associated Environmental, Inc. by (signature) William R. Colman