

1931W16BBD


TRACTOR

WATER WELL RECORD
KSA 82a-1201-1215

Kansas Department of Health and
Environment-Division of Environment
(Water well Contractors)
Topeka, Kansas 66620

USE TYPEWRITER OR BALL
POINT PEN IN PRESS. FIRMLY
PRINT, CLEARLY.

BBD

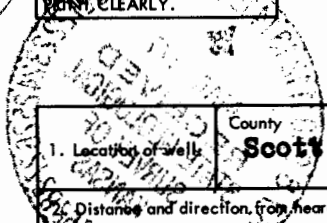

1. Location of well	County Scott	Fraction SE 1/4 NW 1/4 NW 1/4	Section number 16	Township number T 19	Range number S R 31	E/W E/W
---------------------	------------------------	---	-----------------------------	--------------------------------	-------------------------------	-------------------

2. Distance and direction from nearest town or city:
0 mi. East, 5 mi. South of Scott City
Street address of well location if in city: **40 rds E., 60 rds S.**

3. Owner of well: **Alva & Raymond Dearden**
R.R. or street: **Rte. #2**
City, state, zip code: **Scott City, Kansas 67871**

4. Locote with "X" in section below: Sketch map:

N

W	XW	NE	E
	SW	SE	

S

1 Mile

6. Bore hole dia. **24** in. Completion date **12/12/75**
Well depth **140** ft.

7. Cable tool Rotary Driven Dug
 Hollow rod Jetted Bored Reverse rotary

8. Use: Domestic Public supply Industry
 Irrigation Air conditioning Stock
 Lawn Oil field water Other

9. Casing: Material **Steel** Height: Above or below
Threaded Welded Surface **12** in.
RMP PVC Weight **3686** lbs./ft. **219**
Dia. **16** in. to **140** ft. depth Wall Thickness: inches or
Dia. in. to ft. depth gage No. **219** **MHC**

5. Type and color of material	From	To
sandy clay	0	40
clay, Gyp	40	80
yellow clay	80	100
brown clay	100	140
BRICK		
PUMP TO BE INSTALLED LATER.		

(Use a second sheet if needed)

10. Screen: Manufacturer's name **none**
(crackhole)
Type Dia.
Slot/gauze Length
Set between ft. and ft.
 ft. and ft.
Gravel pack? Size range of material

11. Static water level: mo./day/yr.
81 ft. below land surface Date **12/12/75**

12. Pumping level below land surfaces:
81 ft. after hrs. pumping **400** g.p.m.
 ft. after hrs. pumping g.p.m.
Estimated maximum yield **400** g.p.m.

13. Water sample submitted: mo./day/yr.
Yes No Date

14. Well head completion:
 Pitless adapter Inches above grade

15. Well grouted? **yes**
With: Neat cement Bentonite Concrete
Depth: From **0** ft. to **10** ft.

16. Nearest source of possible contamination: **Field**
ft. Direction Type **N.A.**
Well disinfected upon completion? Yes No

17. Pump: Not installed
Manufacturer's name
Model number HP Volts
Length of drop pipe ft. capacity g.p.m.
Type:
 Submersible Turbine
 Jet Reciprocating
 Centrifugal Other

18. Elevation:

Topography:
 Hill
 Slope
 Upland
 Valley

19. Remarks: **2989 (TOP)**
Customer will complete according to Regulation.
Alva Dearden Raymond Dearden
Dearden

20. Water well contractor's certification:
This well was drilled under my jurisdiction and this report is true to the best of my knowledge and belief.
High Plains Drilling Co. License No. 156
Business name License No.
Address **402 N. 3rd Street, Scott City, Mo.**
Signed *High Plains Drilling Co.* Date **1-2-76**
Authorized representative

T 19
R 31
S R 31
E/W
Sec
1/4 SE NW NW

Forward the white, blue and pink copies to the Department of Health and Environment

Form WWC-5