


1 LOCATION OF WATER WELL: Fraction Section Number Township Number Range Number
 COUNTY: 086 SCOTT NE 1/4 SE 1/4 SE 1/4 30 T 19 S R 33 W

Distance and direction from nearest town or city street address of well if located within city?
 FROM SHALLOW WATER; APPX 4 3/4 MILES WEST & 1/4 MILE SOUTH

2 WATER WELL OWNER: FAIRLEIGH FEED YARD
 RR#, St. Address, Box #: PO BOX 560 Board of Agriculture, Division of Water Resources
 City, State, ZIP code : SCOTT CITY, KS 67871-0560 Application Number: 44,997

3 LOCATE WELL'S LOCATION WITH AN "X" IN SECTION BOX:

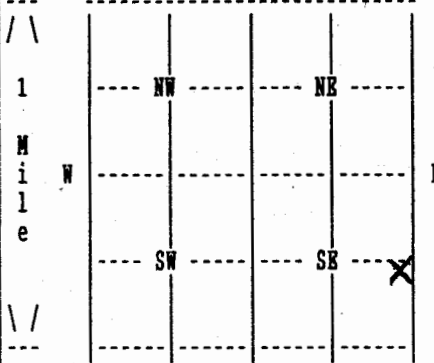

4 DEPTH OF COMPLETED WELL 869 ELEVATION: 0
 Depth(s) Groundwater Encountered 1. 0 ft. 2. 0 ft. 3. 0 ft.

WELL'S STATIC WATER LEVEL 0 ft. below land surface measured on mo/day/yr
 Pump test data: Well water was 0 ft. after 0 hours pumping 0 gpm
 Estimated Yield 0 gpm: Well water was 0 ft. after 0 hours pumping 0 gpm
 Bore Hole Diameter 20 in. to 869 ft., and in. to 0 ft.
 WELL WATER TO BE USED AS: 03 FEEDLOT

Was a chemical/bacteriological sample submitted to department? No ;
 If yes, mo/day/yr sample was submitted Water well disinfected? Yes

5 TYPE OF BLANK CASING USED: 02 PVC CASING JOINTS: GLUED
 Blank casing diameter 8 in. to 869 ft., Dia in. to 0 ft., Dia in. to 0 ft.
 Casing height above land surface 12 in., weight 8 lbs/ft. Wall thickness or gauge No. .500
 TYPE OF SCREEN OR PERFORATION MATERIAL: 07 PVC
 SCREEN OR PERFORATION OPENINGS ARE: 03 MILL SLOT

SCREEN PERFORATED INTERVALS: From 709 ft. to 869 ft., From 0 ft. to 0 ft.
 From 0 ft. to 0 ft., From 0 ft. to 0 ft.
 GRAVEL PACK INTERVALS: From 25 ft. to 150 ft., From 190 ft. to 869 ft.
 From 0 ft. to 0 ft., From 0 ft. to 0 ft.

6 GROUT MATERIAL 03 BENTONITE
 Grout Intervals: From 5 ft. to 25 ft., From 150 ft. to 190 ft., From 0 ft. to 0 ft.
 What is the nearest source of possible contamination: NONE OBSERVED
 Direction from well? How many feet? 0

FROM	TO	LITHOLOGIC LOG	FROM	TO	PLUGGING INTERVALS
0	2	02 SILT			
2	22	01 CLAY 04 SANDY CLAY			
22	34	05 SAND 13 FINE GRAVEL 01 CLAY			
34	40	04 SANDY CLAY			
40	88	05 SAND 11 GRAVEL 01 CLAY			
88	103	01 CLAY 05 SAND			
103	109	05 SAND			
109	122	01 CLAY			
122	144	04 SANDY CLAY 05 SAND 31 CALICHE			
144	254	19 SHALE			

7 CONTRACTOR'S OR LANDOWNER'S CERTIFICATION: This water well was Constructed under my jurisdiction and was completed on (mo/day/year) 09/23/04 and this record is true to the best of my knowledge and belief. Kansas Water Well Contractor's License No. 145 This Water Well Record was completed on (mo/day/yr) 11/05/04 under the business name of HENKLE DRILLING & SUPPLY by (signature)

1 LOCATION OF WATER WELL: COUNTY: 086 SCOTT	Fraction NE 1/4 SE 1/4 SE 1/4	Section Number 30	Township Number T 19 S	Range Number R 33 W
--	----------------------------------	----------------------	---------------------------	------------------------

2 WATER WELL OWNER: FAIRLEIGH FEED YARD
 RR#, St. Address, Box # : PO BOX 560 Board of Agriculture, Division of Water Resources
 City, State, ZIP code : SCOTT CITY, KS 67871-0560 Application Number: 44,997

FROM	TO	LITHOLOGIC LOG
254	330	19 SHALE 31 CALICHE 23 SANDSTONE
330	550	19 SHALE
550	595	19 SHALE 31 CALICHE 20 LIMESTONE
595	693	19 SHALE 23 SANDSTONE
693	702	20 LIMESTONE 19 SHALE
702	709	19 SHALE
709	729	23 SANDSTONE 19 SHALE
729	758	23 SANDSTONE 19 SHALE
758	765	19 SHALE
765	868	23 SANDSTONE 19 SHALE
868	911	19 SHALE 01 CLAY 23 SANDSTONE
911	936	19 SHALE 01 CLAY 23 SANDSTONE
936	947	19 SHALE 20 LIMESTONE
947	955	20 LIMESTONE 19 SHALE
955	977	19 SHALE 23 SANDSTONE 28 ROCK
977	983	19 SHALE 20 LIMESTONE

7 CONTRACTOR'S OR LANDOWNER'S CERTIFICATION: This water well was Constructed under my jurisdiction and was completed on (mo/day/year) 09/23/04 and this record is true to the best of my knowledge and belief. Kansas Water Well Contractor's License No. 145 This Water Well Record was completed on (mo/day/yr) 11/05/04 under the business name of HENKLE DRILLING & SUPPLY by (signature) *Bruce J. Richmuth*