


WATER WELL RECORD Form WWC-5 KSA 82a-1212

1 LOCATION OF WATER WELL: Fraction Section Number Township Number Range Number
 COUNTY: 086 SCOTT NE 1/4 NE 1/4 NE 1/4 30 T 19 S R 33 W

Distance and direction from nearest town or city street address of well if located within city?
 FROM SHALLOW WATER; APPX 5 MILES WEST

2 WATER WELL OWNER: FAIRLEIGH CORPORATION
 RR#, St. Address, Box #: 7400 S. FALCON RD Board of Agriculture, Division of Water Resources
 City, State, ZIP code: SCOTT CITY, KS 67871- Application Number: 44,998

3 LOCATE WELL'S LOCATION WITH AN "X" IN SECTION BOX:

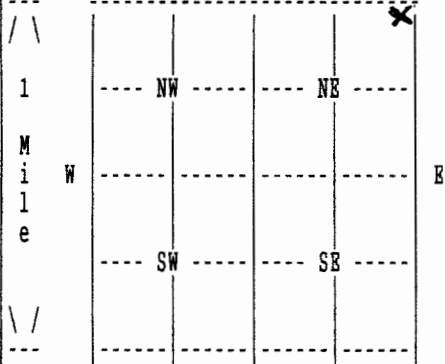

4 DEPTH OF COMPLETED WELL 899 ELEVATION: 0
 Depth(s) Groundwater Encountered 1. 0 ft. 2. 0 ft. 3. 0 ft.

WELL'S STATIC WATER LEVEL 0 ft. below land surface measured on mo/day/yr
 Pump test data: Well water was 0 ft. after 0 hours pumping 0 gpm

Estimated Yield 0 gpm: Well water was 0 ft. after 0 hours pumping 0 gpm

Bore Hole Diameter 17.5 in. to 899 ft., and in. to 0 ft.

WELL WATER TO BE USED AS: 03 FEEDLOT

Was a chemical/bacteriological sample submitted to department? No ;
 If yes, mo/day/yr sample was submitted Water well disinfected? Yes

5 TYPE OF BLANK CASING USED: 02 PVC CASING JOINTS: GLUED
 Blank casing diameter 8 in. to 899 ft., Dia in. to 0 ft., Dia in. to 0 ft.
 Casing height above land surface 12 in., weight 8 lbs/ft. Wall thickness or gauge No. .500
 TYPE OF SCREEN OR PERFORATION MATERIAL: 07 PVC
 SCREEN OR PERFORATION OPENINGS ARE: 03 MILL SLOT

SCREEN PERFORATED INTERVALS: From 719 ft. to 899 ft., From 0 ft. to 0 ft.
 From 0 ft. to 0 ft., From 0 ft. to 0 ft.
 GRAVEL PACK INTERVALS: From 25 ft. to 899 ft., From 0 ft. to 0 ft.
 From 0 ft. to 0 ft., From 0 ft. to 0 ft.

6 GROUT MATERIAL 03 BENTONITE
 Grout Intervals: From 5 ft. to 25 ft., From 0 ft. to 0 ft., From 0 ft. to 0 ft.
 What is the nearest source of possible contamination: NONE OBSERVED
 Direction from well? How many feet? 0

FROM	TO	LITHOLOGIC LOG	FROM	TO	PLUGGING INTERVALS
0	2	02 SILT			
2	69	01 CLAY			
69	78	05 SAND 13 FINE GRAVEL 28 ROCK			
78	82	04 SANDY CLAY			
82	102	05 SAND 13 FINE GRAVEL 28 ROCK			
102	122	01 CLAY 05 SAND			
122	138	07 FINE SAND 08 MEDIUM SAND 04 SANDY CLAY			
138	157	04 SANDY CLAY			
157	164	01 CLAY			
164	260	19 SHALE			

7 CONTRACTOR'S OR LANDOWNER'S CERTIFICATION: This water well was Constructed under my jurisdiction and was completed on (mo/day/year) 10/17/04 and this record is true to the best of my knowledge and belief. Kansas Water Well Contractor's License No. 145 This Water Well Record was completed on (mo/day/yr) 01/13/05 under the business name of HENKLE DRILLING & SUPPLY by (signature)

1 LOCATION OF WATER WELL: COUNTY: 086 SCOTT	Fraction NE 1/4 NE 1/4 NE 1/4	Section Number 30	Township Number T 19 S	Range Number R 33 W
--	----------------------------------	----------------------	---------------------------	------------------------

2 WATER WELL OWNER: FAIRLEIGH CORPORATION
 RR#, St. Address, Box # : 7400 S. FALCON RD Board of Agriculture, Division of Water Resources
 City, State, ZIP code : SCOTT CITY, KS 67871- Application Number: 44,998

FROM	TO	LITHOLOGIC LOG
260	290	19 SHALE 31 CALICHE
290	330	31 CALICHE 19 SHALE
330	457	19 SHALE
457	570	19 SHALE
570	590	19 SHALE 20 LIMESTONE
590	620	19 SHALE 31 CALICHE
620	670	19 SHALE
670	700	19 SHALE 23 SANDSTONE
700	711	20 LIMESTONE 19 SHALE
711	719	19 SHALE
719	745	19 SHALE 23 SANDSTONE
745	762	23 SANDSTONE 19 SHALE
762	801	23 SANDSTONE 19 SHALE 20 LIMESTONE
801	822	19 SHALE 23 SANDSTONE
822	835	19 SHALE 23 SANDSTONE
835	880	23 SANDSTONE 19 SHALE
880	897	23 SANDSTONE 19 SHALE 20 LIMESTONE
897	948	19 SHALE 23 SANDSTONE 31 CALICHE
948	983	19 SHALE

7 CONTRACTOR'S OR LANDOWNER'S CERTIFICATION: This water well was Constructed under my jurisdiction and was completed on (mo/day/year) 10/17/04 and this record is true to the best of my knowledge and belief. Kansas Water Well Contractor's License No. 145 This Water Well Record was completed on (mo/day/yr) 01/13/05 under the business name of HENKLE DRILLING & SUPPLY by (signature) *Bruce R. Kuntz*