

Corrected

WATER WELL RECORD


Form WWC-5

Division of Water Resources App. No. 2010 0085

1 LOCATION OF WATER WELL: Fraction Section Number Township Number Range Number

Street/Rural Address of Well Location; if unknown, distance & direction from nearest town or intersection: If at owner's address, check here. Global Positioning System (GPS) information:

2 WATER WELL OWNER: Vulgamore Cattle Co Inc. RR#, St. Address, Box # : 8250 S Mesquite Rd City, State, ZIP Code : Scott City, Ks 67851

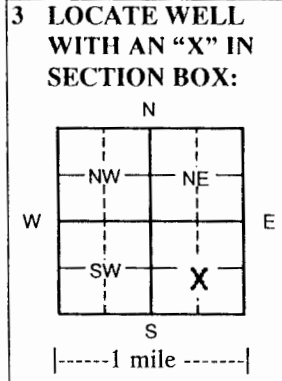

3 LOCATE WELL WITH AN "X" IN SECTION BOX: 4 DEPTH OF COMPLETED WELL 150 ft. Depth(s) Groundwater Encountered (1) ft. (2) ft. (3) ft. WELL'S STATIC WATER LEVEL na ft. below land surface measured on mo/day/yr

5 TYPE OF CASING USED: Steel PVC Other CASING JOINTS: Glued Clamped Welded Threaded Casing diameter 4.5 in. to 110 ft., Diameter in. to ft., Diameter in. to ft. Casing height above land surface 18 in., Weight 2.38 lbs./ft. Wall thickness or gauge No. 248

6 GROUT MATERIAL: Neat cement Cement grout Bentonite Other Grout Intervals From 0 ft. to 20 ft. From ft. to ft. From ft. to ft. What is the nearest source of possible contamination:

Table with columns: FROM, TO, LITHOLOGIC LOG, FROM, TO, LITHO. LOG (cont.) or PLUGGING INTERVALS. Rows include Surface, Loess, Fine sand, Clay w/caliche strks, Fine sand & sandy clay mix w/clay & caliche strks, Clay w/sandy clay lenses, Fine to some med sand w/clay strks, Clay & caliche w/sand lenses, Fine sand w/clay strks, Fine to some med sand w/clay strks.

7 CONTRACTOR'S OR LANDOWNER'S CERTIFICATION: This water well was constructed, reconstructed, or plugged under my jurisdiction and was completed on (mo/day/year) 2-24-10 and this record is true to the best of my knowledge and belief.

INSTRUCTIONS: Please fill in blanks and check the correct answers. Send three copies (white, blue, pink) to Kansas Department of Health and Environment, Bureau of Water, Geology Section, 1000 SW Jackson St., Suite 420, Topeka, Kansas 66612-1367. Telephone 785-296-5522. Send one to WATER WELL OWNER and retain one for your records. Include fee of \$5.00 for each constructed well. Visit us at http://www.kdheks.gov/waterwell/index.html.

CORRECTED