


1 LOCATION OF WATER WELL: County: Scott Fraction: NE 1/4 NE 1/4 NE 1/4 Section Number: 24 Township Number: T 19 S Range Number: R 33 E(11)

Distance and direction from nearest town or city street address of well if located within city?

1/2 mile north of Shallow Water, Ks.

2 WATER WELL OWNER: Kenneth Trout
 RR#, St. Address, Box #: Shallow Water, Ks. 67871
 City, State, ZIP Code: Shallow Water, Ks. 67871
 Board of Agriculture, Division of Water Resources
 Application Number: _____

3 LOCATE WELL'S LOCATION WITH AN "X" IN SECTION BOX: 4 DEPTH OF COMPLETED WELL: 140 ft. ELEVATION: _____

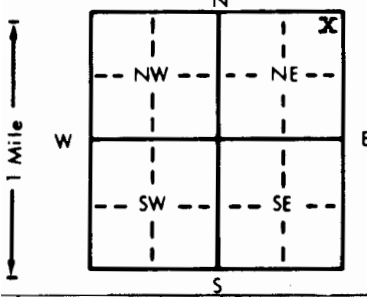

Depth(s) Groundwater Encountered 1. _____ ft. 2. _____ ft. 3. _____ ft.
 WELL'S STATIC WATER LEVEL 58 ft. below land surface measured on mo/day/yr 5-8-86
 Pump test data: Well water was _____ ft. after _____ hours pumping _____ gpm
 Est. Yield 25 gpm: Well water was _____ ft. after _____ hours pumping _____ gpm
 Bore Hole Diameter 12 in. to 140 ft., and _____ in. to _____ ft.
 WELL WATER TO BE USED AS:
 Domestic 3 Feedlot 6 Oil field water supply 9 Dewatering 12 Other (Specify below)
 2 Irrigation 4 Industrial 7 Lawn and garden only 10 Observation well
 Was a chemical/bacteriological sample submitted to Department? Yes _____ No ; If yes, mo/day/yr sample was submitted _____
 Water Well Disinfected? Yes No _____

5 TYPE OF BLANK CASING USED:
 1 Steel 3 RMP (SR) 5 Wrought iron 8 Concrete tile CASING JOINTS: Glued Clamped _____
 PVC 4 ABS 7 Fiberglass _____ Welded _____
 Threaded _____

Blank casing diameter 5 in. to 120 ft., Dia _____ in. to _____ ft., Dia _____ in. to _____ ft.
 Casing height above land surface 12 in., weight _____ lbs./ft. Wall thickness or gauge No. 200 psi

TYPE OF SCREEN OR PERFORATION MATERIAL:
 PVC 10 Asbestos-cement
 1 Steel 3 Stainless steel 5 Fiberglass 8 RMP (SR) 11 Other (specify) _____
 2 Brass 4 Galvanized steel 6 Concrete tile 9 ABS 12 None used (open hole)

SCREEN OR PERFORATION OPENINGS ARE:
 1 Continuous slot 3 Mill slot 5 Gauzed wrapped Saw cut 11 None (open hole)
 2 Louvered shutter 4 Key punched 6 Wire wrapped 9 Drilled holes
 7 Torch cut 10 Other (specify) _____

SCREEN-PERFORATED INTERVALS: From 120 ft. to 140 ft., From _____ ft. to _____ ft.
 From _____ ft. to _____ ft., From _____ ft. to _____ ft.
 GRAVEL PACK INTERVALS: From 16 ft. to 110 ft., From _____ ft. to _____ ft.
 From 120 ft. to 140 ft., From _____ ft. to _____ ft.

6 GROUT MATERIAL: Neat cement 2 Cement grout Bentonite 4 Other _____
 Grout Intervals: From 6 ft. to 16 ft., From 110 ft. to 120 ft., From _____ ft. to _____ ft.

What is the nearest source of possible contamination:
 Septic tank 4 Lateral lines 7 Pit privy 10 Livestock pens 14 Abandoned water well
 2 Sewer lines 5 Cess pool 8 Sewage lagoon 11 Fuel storage 15 Oil well/Gas well
 3 Watertight sewer lines 6 Seepage pit 9 Feedyard 12 Fertilizer storage 16 Other (specify below)
 13 Insecticide storage _____

Direction from well? _____ How many feet? 100

FROM	TO	LITHOLOGIC LOG	FROM	TO	LITHOLOGIC LOG
0	2	top soil			
2	20	brown clay			
20	50	gray clay			
50	75	fine to medium sand			
75	120	blue & gray clay			
120	140	fine sand, clay streaks			

7 CONTRACTOR'S OR LANDOWNER'S CERTIFICATION: This water well was constructed, (2) reconstructed, or (3) plugged under my jurisdiction and was completed on (mo/day/year) 5-8-86 and this record is true to the best of my knowledge and belief. Kansas Water Well Contractor's License No. 449 This Water Well Record was completed on (mo/day/yr) 5-15-86 under the business name of Midwest Well & Pump by (signature) Arthur Kuhlman

INSTRUCTIONS: Use typewriter or ball point pen, PLEASE PRESS FIRMLY and PRINT clearly. Please fill in blanks, underline or circle the correct answers. Send top three copies to Kansas Department of Health and Environment, Division of Environment, Environmental Geology Section, Topeka, KS 66620. Send one to WATER WELL OWNER and retain one for your records.

OFFICE USE ONLY T R E W SEC.