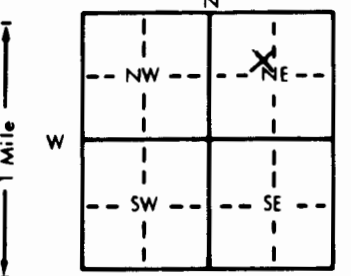


1 LOCATION OF WATER WELL: Fraction SE 1/4 NW 1/4 NE 1/4 Section Number 24 Township Number T 19 S Range Number R 33 E/W
 County: Scott
 Distance and direction from nearest town or city street address of well if located within city?

2 WATER WELL OWNER: Harold Trout
 RR#, St. Address, Box #: Rt. #2, Box 71 Board of Agriculture, Division of Water Resources
 City, State, ZIP Code: Scott City, KS 67871 Application Number:

3 LOCATE WELL'S LOCATION WITH AN "X" IN SECTION BOX:

 4 DEPTH OF COMPLETED WELL: 172 ft. ELEVATION:
 Depth(s) Groundwater Encountered 1. ft. 2. ft. 3. ft.
 WELL'S STATIC WATER LEVEL: 69 ft. below land surface measured on mo/day/yr 4-27-93
 Pump test data: Well water was ft. after hours pumping gpm
 Est. Yield gpm: Well water was ft. after hours pumping gpm
 Bore Hole Diameter in. to ft., and in. to ft.
 WELL WATER TO BE USED AS:
 5 Public water supply 8 Air conditioning 11 Injection well
 1 Domestic 3 Feedlot 6 Oil field water supply 9 Dewatering 12 Other (Specify below)
 Irrigation 4 Industrial 7 Lawn and garden only 10 Monitoring well
 Was a chemical/bacteriological sample submitted to Department? Yes.....No; If yes, mo/day/yr sample was submitted
 Water Well Disinfected? Yes No

5 TYPE OF BLANK CASING USED:
 Steel 3 RMP (SR) 5 Wrought iron 8 Concrete tile CASING JOINTS: Glued Clamped
 2 PVC 4 ABS 6 Asbestos-Cement 9 Other (specify below) Welded
 7 Fiberglass Threaded
 Blank casing diameter 14 in. to ft., Dia in. to ft., Dia in. to ft.
 Casing height above land surface: 3' below in., weight lbs./ft. Wall thickness or gauge No.
 TYPE OF SCREEN OR PERFORATION MATERIAL:
 1 Steel 3 Stainless steel 5 Fiberglass 7 PVC 10 Asbestos-cement
 2 Brass 4 Galvanized steel 6 Concrete tile 9 ABS 11 Other (specify)
 12 None used (open hole)
 SCREEN OR PERFORATION OPENINGS ARE:
 1 Continuous slot 3 Mill slot 5 Gauzed wrapped 8 Saw cut 11 None (open hole)
 2 Louvered shutter 4 Key punched 6 Wire wrapped 9 Drilled holes
 7 Torch cut 10 Other (specify)
 SCREEN-PERFORATED INTERVALS: From ft. to ft., From ft. to ft.
 From ft. to ft., From ft. to ft.
 GRAVEL PACK INTERVALS: From ft. to ft., From ft. to ft.
 From ft. to ft., From ft. to ft.

6 GROUT MATERIAL: 1 Neat cement 2 Cement grout Bentonite Chips 4 Other
 Grout Intervals: From 3 ft. to 6 ft., From ft. to ft., From ft. to ft.
 What is the nearest source of possible contamination: none
 1 Septic tank 4 Lateral lines 7 Pit privy 10 Livestock pens 14 Abandoned water well
 2 Sewer lines 5 Cess pool 8 Sewage lagoon 11 Fuel storage 15 Oil well/Gas well
 3 Watertight sewer lines 6 Seepage pit 9 Feedyard 12 Fertilizer storage 16 Other (specify below)
 13 Insecticide storage
 Direction from well? How many feet?

FROM	TO	LITHOLOGIC LOG	FROM	TO	PLUGGING INTERVALS
			<u>6</u>	<u>172</u>	<u>washed sand & gravel - 6 1/2 yds</u>
			<u>3</u>	<u>6</u>	<u>bentonite 200 lbs.</u>
			<u>0</u>	<u>3</u>	<u>top soil</u>

7 CONTRACTOR'S OR LANDOWNER'S CERTIFICATION: This water well was (1) constructed, (2) reconstructed, or plugged under my jurisdiction and was completed on (mo/day/year) 4-27-93 and this record is true to the best of my knowledge and belief. Kansas Water Well Contractor's License No. 532 This Water Well Record was completed on (mo/day/yr) 5-17-93 under the business name of Midwest Well & Pump by (signature) Victor Jankup

OFFICE USE ONLY
T
R
EW
SEC.